


County of Riverside
ASSESSOR MAP SECTION: 757

Subdivision or Tract Name	Map Page	Lots	Recorders	
			Book	Page
THERMAL TOWNSITE	02 04	BLK'S. A & B	4	69
" "	02 04	BLK. 1	4	78
" "	04	BLK'S. 7-8	"	"
" "	05	BLK'S. 2-6	"	"
DURBROW	29	BLK'S. 2-4 & 6-8	6	40
"	30	BLK'S. 1 & 5	"	"
GILBERTA ACRES	02	6-9	9	21
" "	03	13-14	"	"
" "	06	15-29	"	"
ALDERMAN ACRES TRACT	02	1-35	22	21
Parcel Map 15682	09	1-3.	88	20
" " 17611	14	1-2	110	42
" " 22979	32	1-3	160	36-38
R.S.	24	Par. 1	30	72
"	25	" 2 & 3	"	"

SECS. 22-27, 34-36, T.6S, R.8E.

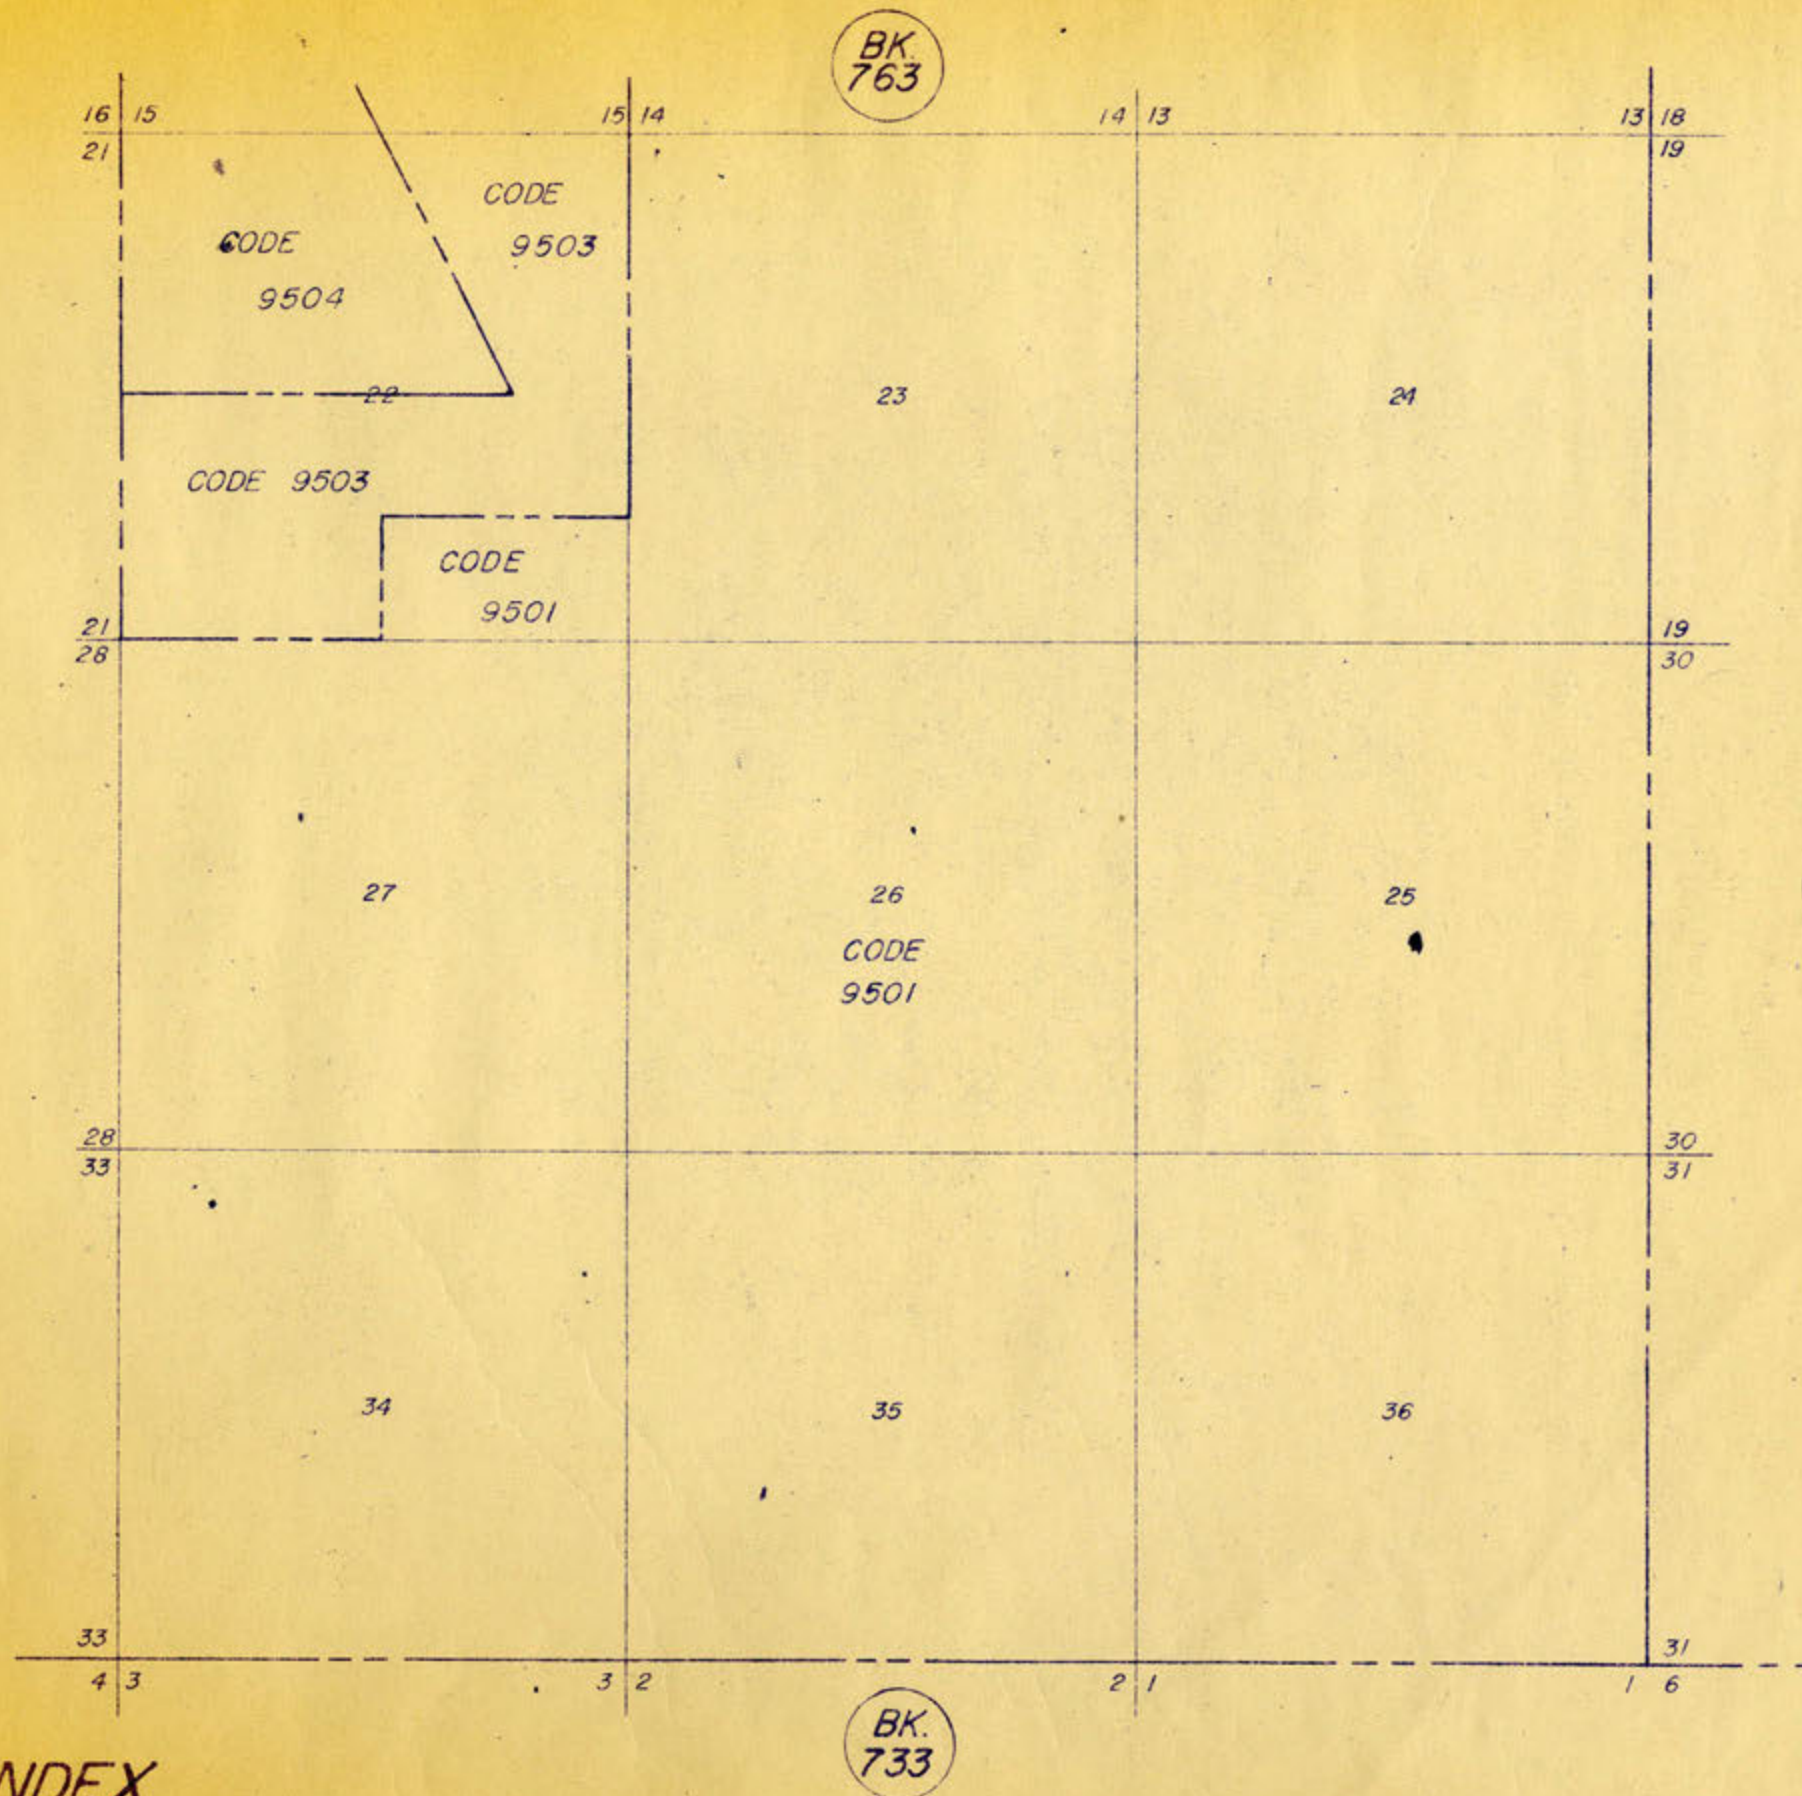

CODE AREA INDEX

FEBRUARY 1967

CODE AREA INDEX
BOOK 757ASSESSOR'S MAP
RIVERSIDE COUNTY, CALIF. MS. VII

757

MAP INDEX 1 of 3

SECS. 22-24, T.6S, R.8E.

Coachella Valley ST

SUPERV. #4
DIST.


T.U.M.F.
Req'd.

IN
REDEVELOPMENT
PLAN PROTECT
NO. 4

BK.
763

BK.
717

1" = 1200'

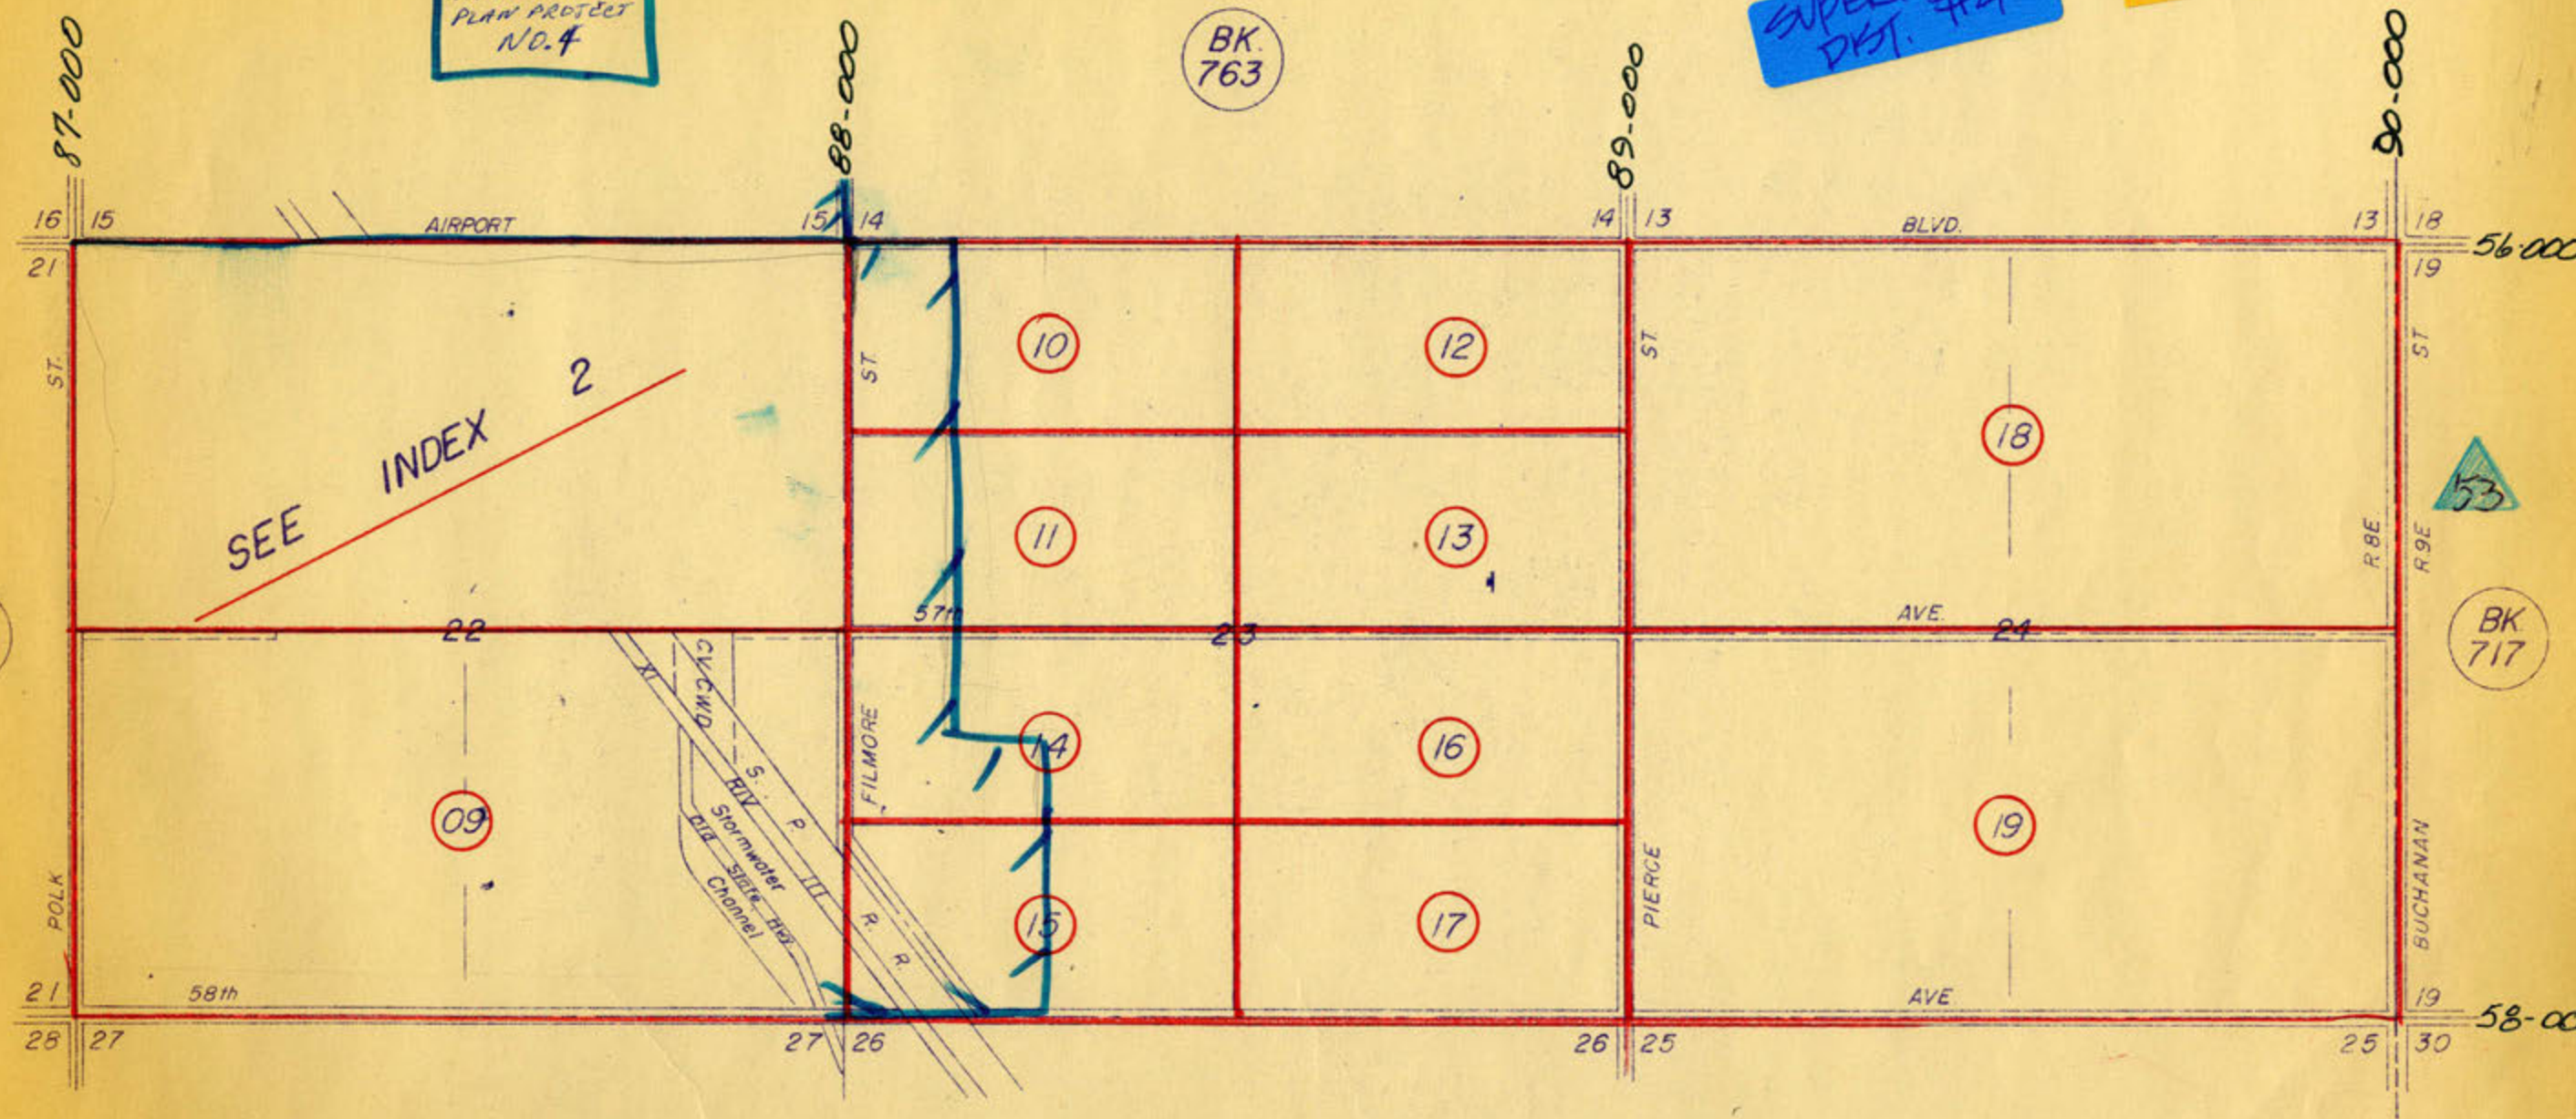

SEE MAP INDEX 3

MAP INDEX 1 of 3

MAP INDEX 1 of 3

BOOK 757


ASSESSOR'S MAP
RIVERSIDE COUNTY, CALIF.

FEBRUARY 1967

757

MAP INDEX 2 of 3

N², SEC. 22, T.6S, R.8E.

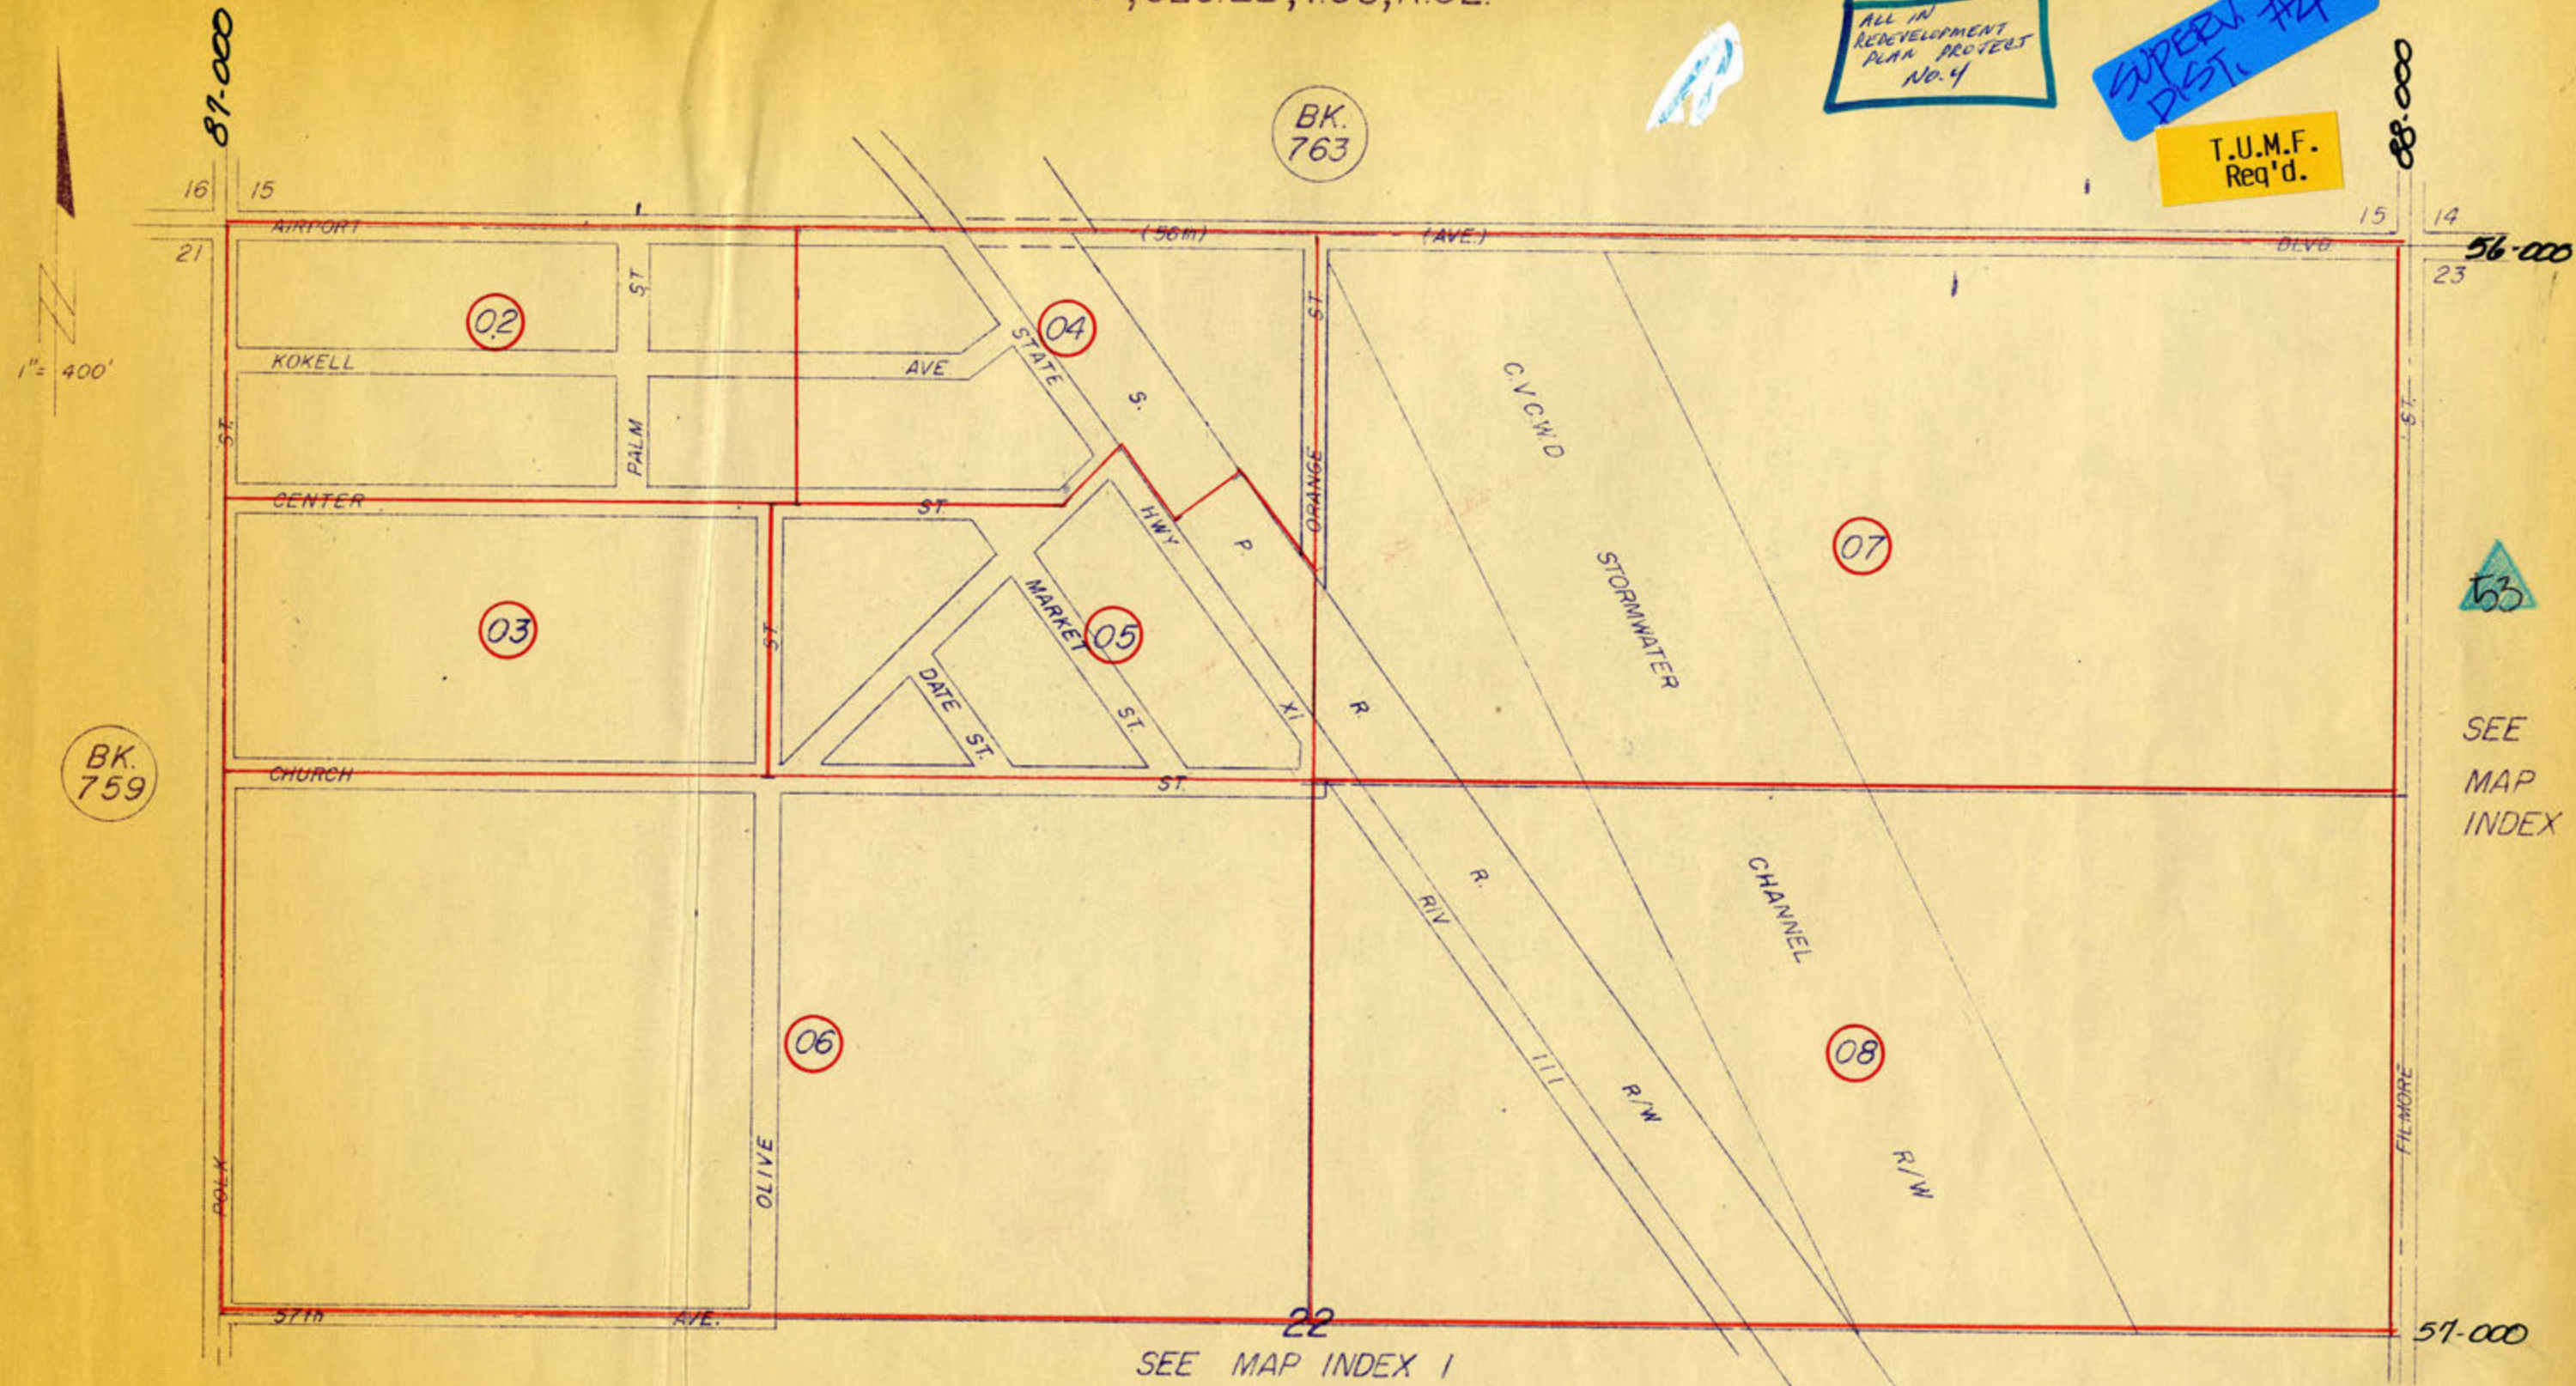

MAP INDEX 2 of 3

FEBRUARY 1967

MAP INDEX 2 of 3
BOOK 757
ASSESSOR'S MAP
RIVERSIDE COUNTY, CALIF

757


MAP INDEX 3 of 3

SECS. 25-27 & 34-36, T.6S, R.8E.

SEE MAP INDEX 1

SUPERV. #4
DIST.

T.U.M.F.
Req'd.

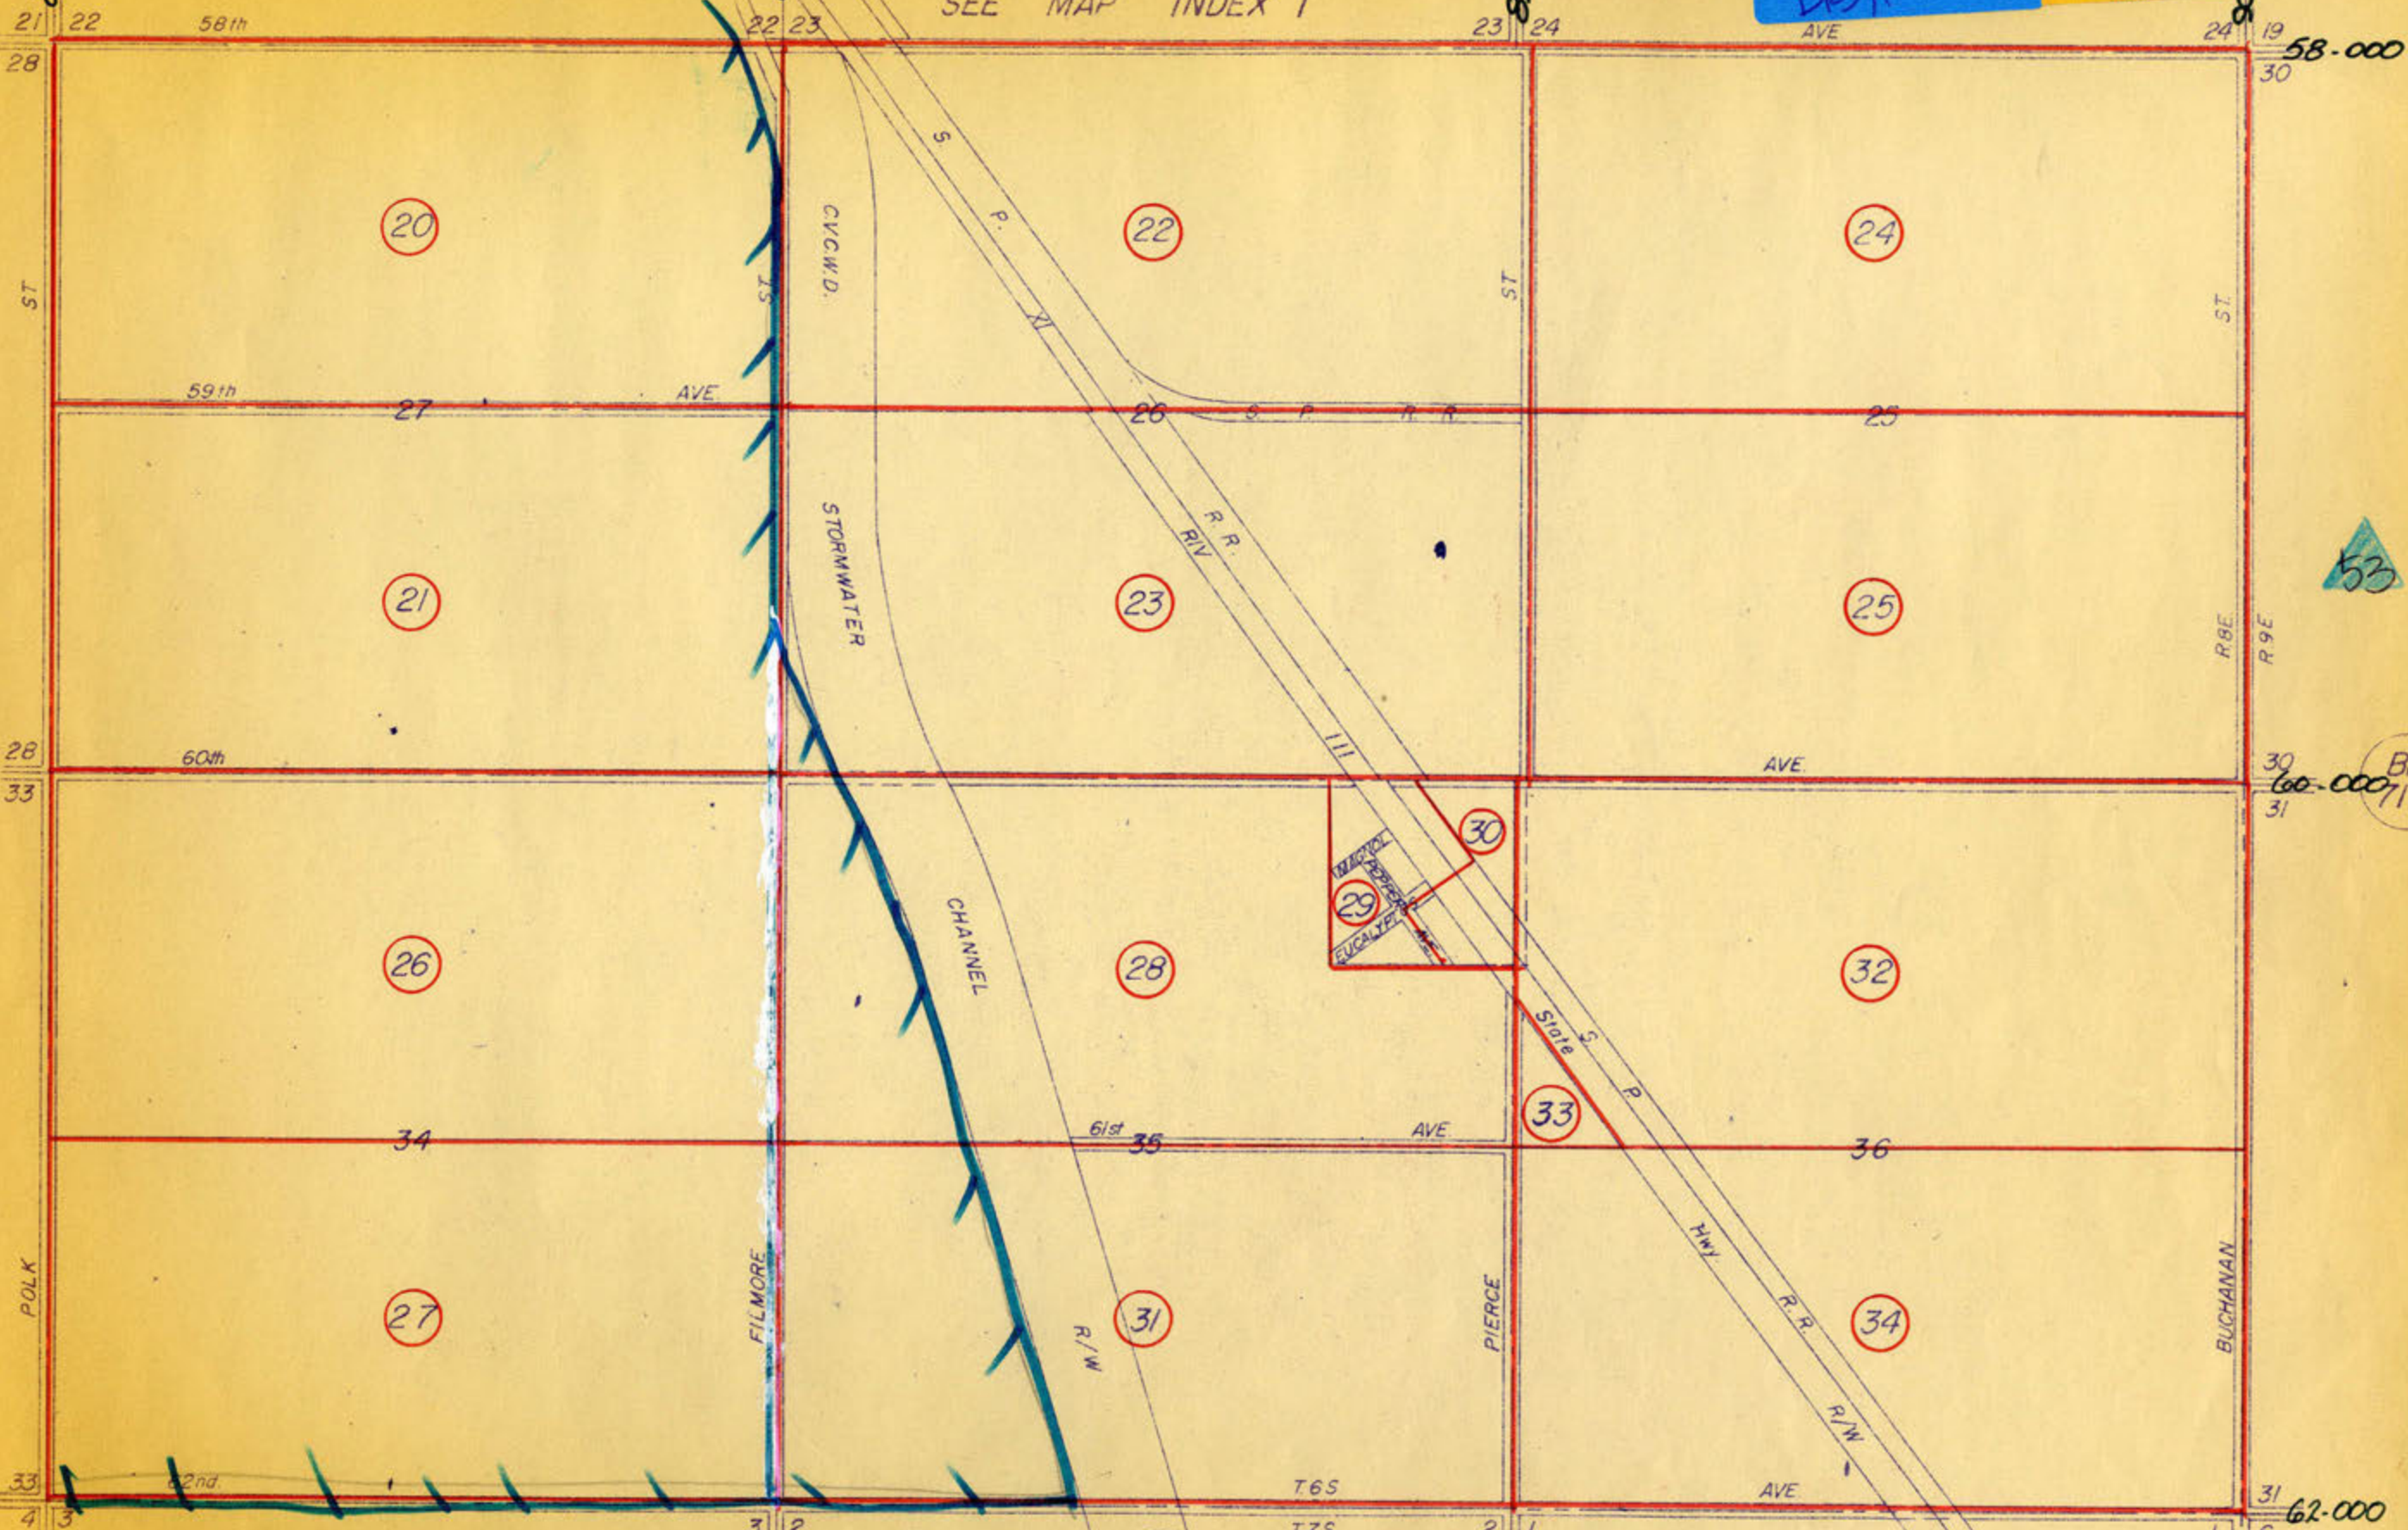

BK.
759

BK.
717

BK.
733

MAP INDEX 3 of 3

FEBRUARY 1967

MAP INDEX 3 of 3

BOOK 757

ASSESSOR'S MAP
RIVERSIDE COUNTY, CALIF.


757-02

25-41

T. C. A. 5850

N², NW⁴, NW⁴, SEC. 22, T. 6 S., R. 8 E.WATER QUALITY CONTROL
Clearance Req'd.

* = Clearance OK!

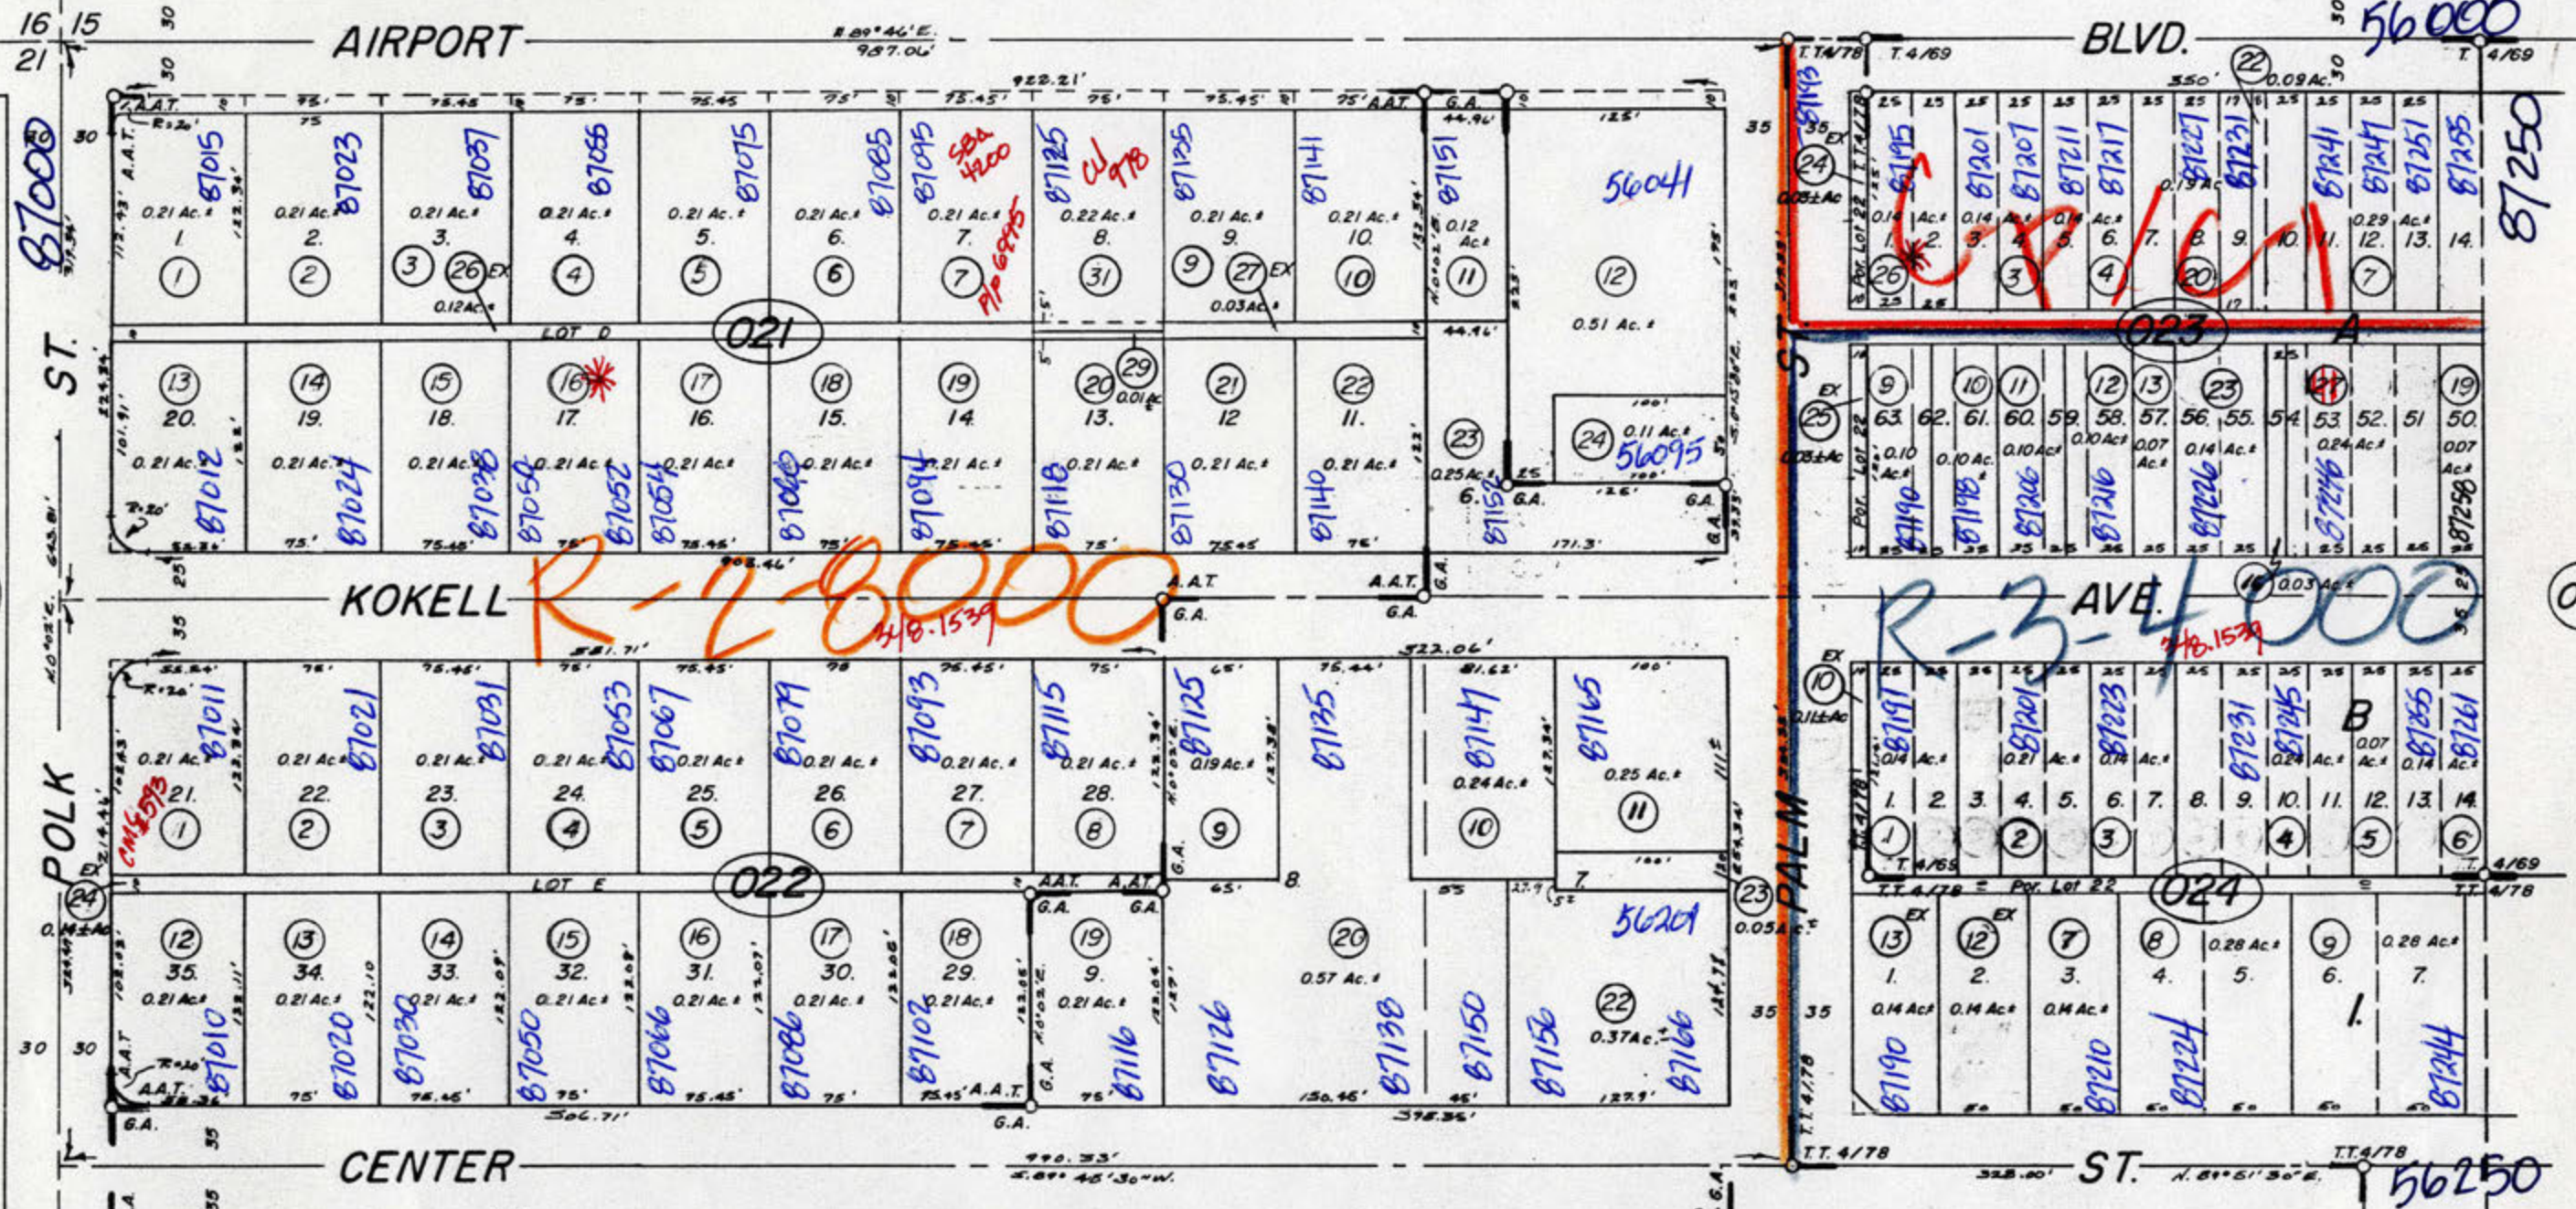BK.
763

DATE	OLD No.	NEW No.
3/73	023-005	023-010
7/75	023-010	023-015
5/76	023-015	023-020
5/76	023-020	023-025
11/77	023-025	26
11/77	023-026	27
7/85	021-25	26-28
1/86	021-28	29, 30
"	021-30	31
8/93	024-11	024-13, ST.

DATA: R.S. 11/30, 11/31, 17/18, GOV'T. PLAT, B. of L.M. - Topo (C-2N-239)

60' Rd. per inst.
32692 4/59

FEBRUARY 1967


Alderman Acres Tract - M.B. 22/20, Gilberta Acres - M.B. 9/21, Thermal Townsite - M.B. 4/69,
Thermal Townsite - M.B. 4/78, All Subdivisions of Sec. 22;

03

ASSESSOR'S MAP BK. 757 PG. 02
RIVERSIDE COUNTY, CALIF.

S2, NW4, NW4, SEC. 22, T. 6S, R. 8E.

WATER QUALITY CONTROL
Clearance Req'd.

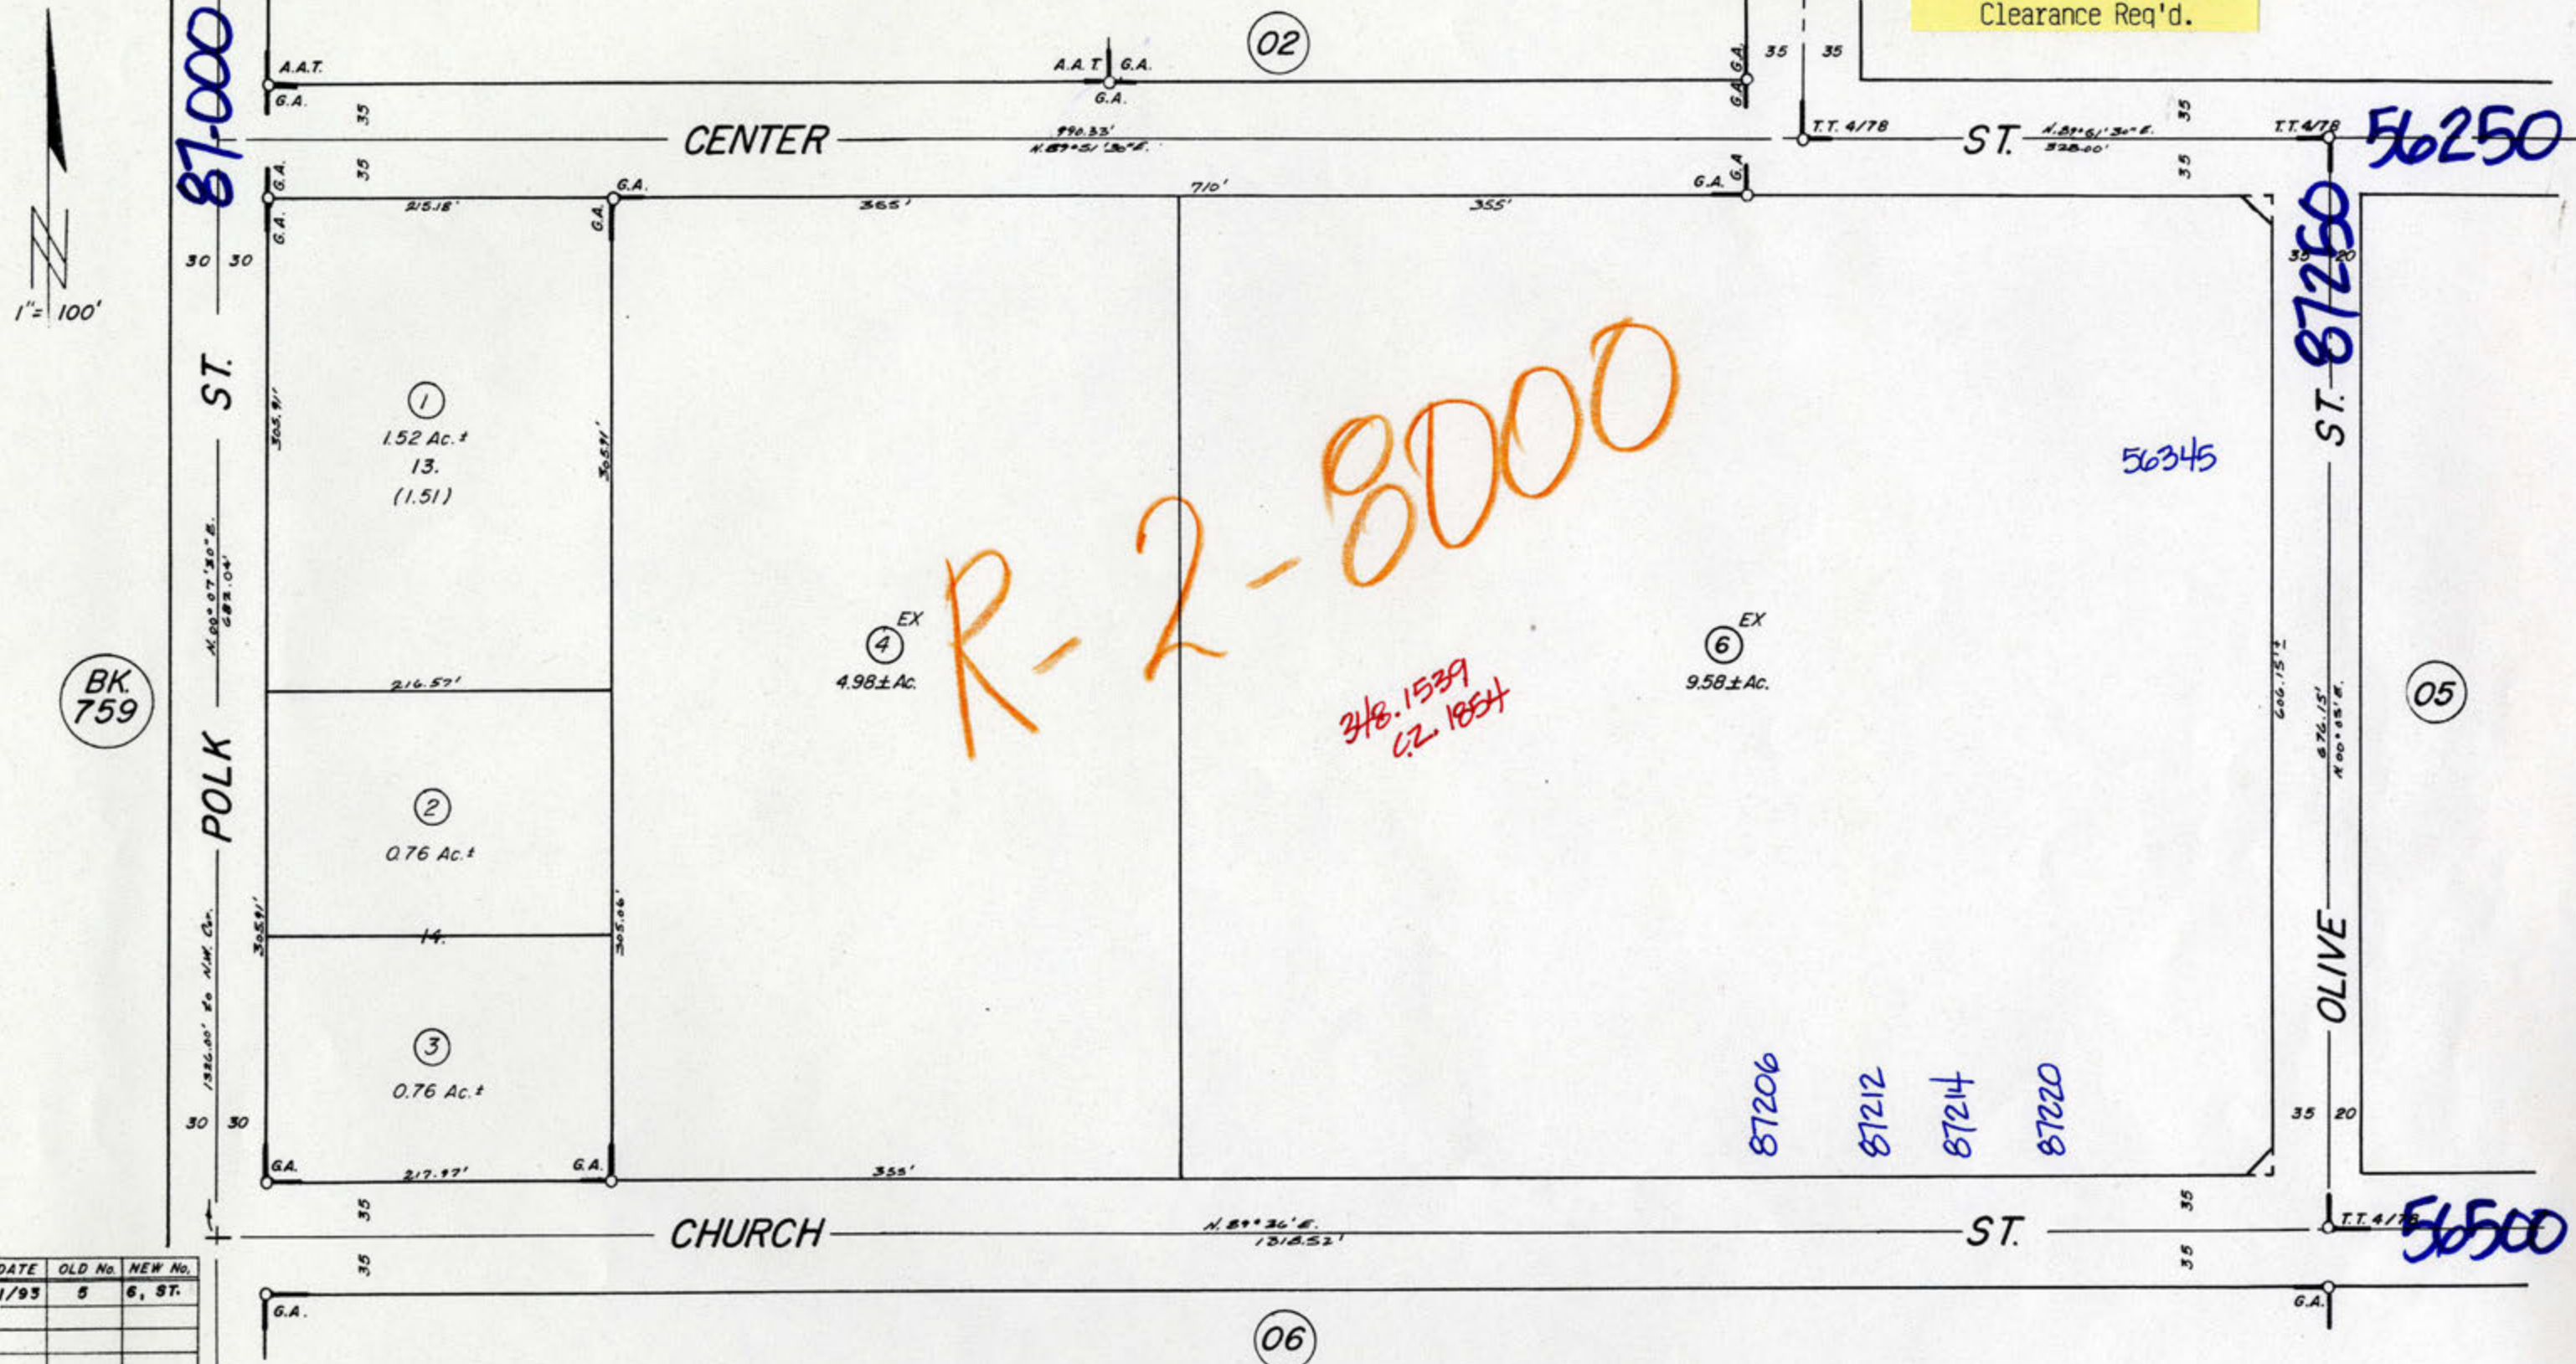[illegible]

Gilberta Acres - M.B. 9/21, Lots 13 & 14, Subdivision of SEC. 22.

DATA: GOV'T. PLAT, R.S. 9/23, 11/30-31, B. of L.M. - Topo. (C-2N-239)

60' Rd. per inst.
32692 4/59

ASSESSOR'S MAP BK.757 PG.03
RIVERSIDE COUNTY, CALIF.

FEBRUARY 1967

NO BLDG. PERMITS -
NEED WATER QUALITY
CLEARANCE.

BK.
763

 $1'' = 100'$

56-000

- BLVD

2 N. 1/4 Corner

AIRPORT

~~needs bldg permit for sign compliance~~
~~next door. Check location for sign~~

insp. code compliance

IV. PROCESS

County Sign. #
offsite sign
Hewood
PIP # 1848

AVE

VIII-RIV-III

⑧ ^{PU}

15.

ORANGE

56-250

T.T. 4/78

CENTER

-ST

(AVE.)

05

DATE	OLD No.	NEW No.
3/67	044-821, 526	044-006
5/75	041-001	041-020
5/75	041-3, 5, 8, 9, 7	041-078
5/75	041-13, 10	041-023
5/75	042-9, 10	042-14
5/75	042-11, 12	042-15
11/77	042-6, 7	16
11/77	041-15, 16	24
11/77	043-2, 3	15
11/77	043-5, 6	16
2/81	043-13, 14	17
11-83	041-22	25

Thermal Townsite - M.B. 4/78

Thermal - " 4/69

DATA: R.S. 11/31, 17/18, B of L.M. -Topo-(C-2N-239); State Hwy. Maps VIII-RIV-III.
S.B.E. 215-33-4, pcl. 1, 215-33-7, pcl. 1, 215-33-10, pcl. 1; 872-33-6 par. pcl. 28

60' Rd per inst.
32692 4/59


FEBRUARY 1967

ASSESSOR'S MAP BK. 757 PG. 04
RIVERSIDE COUNTY, CALIF.

25-41

S², NE⁴, NW⁴, SEC. 22, T. 6 S., R. 8 E.

NO BLDG PERMITS —
NEED WATER QUALITY
CLEARANCE

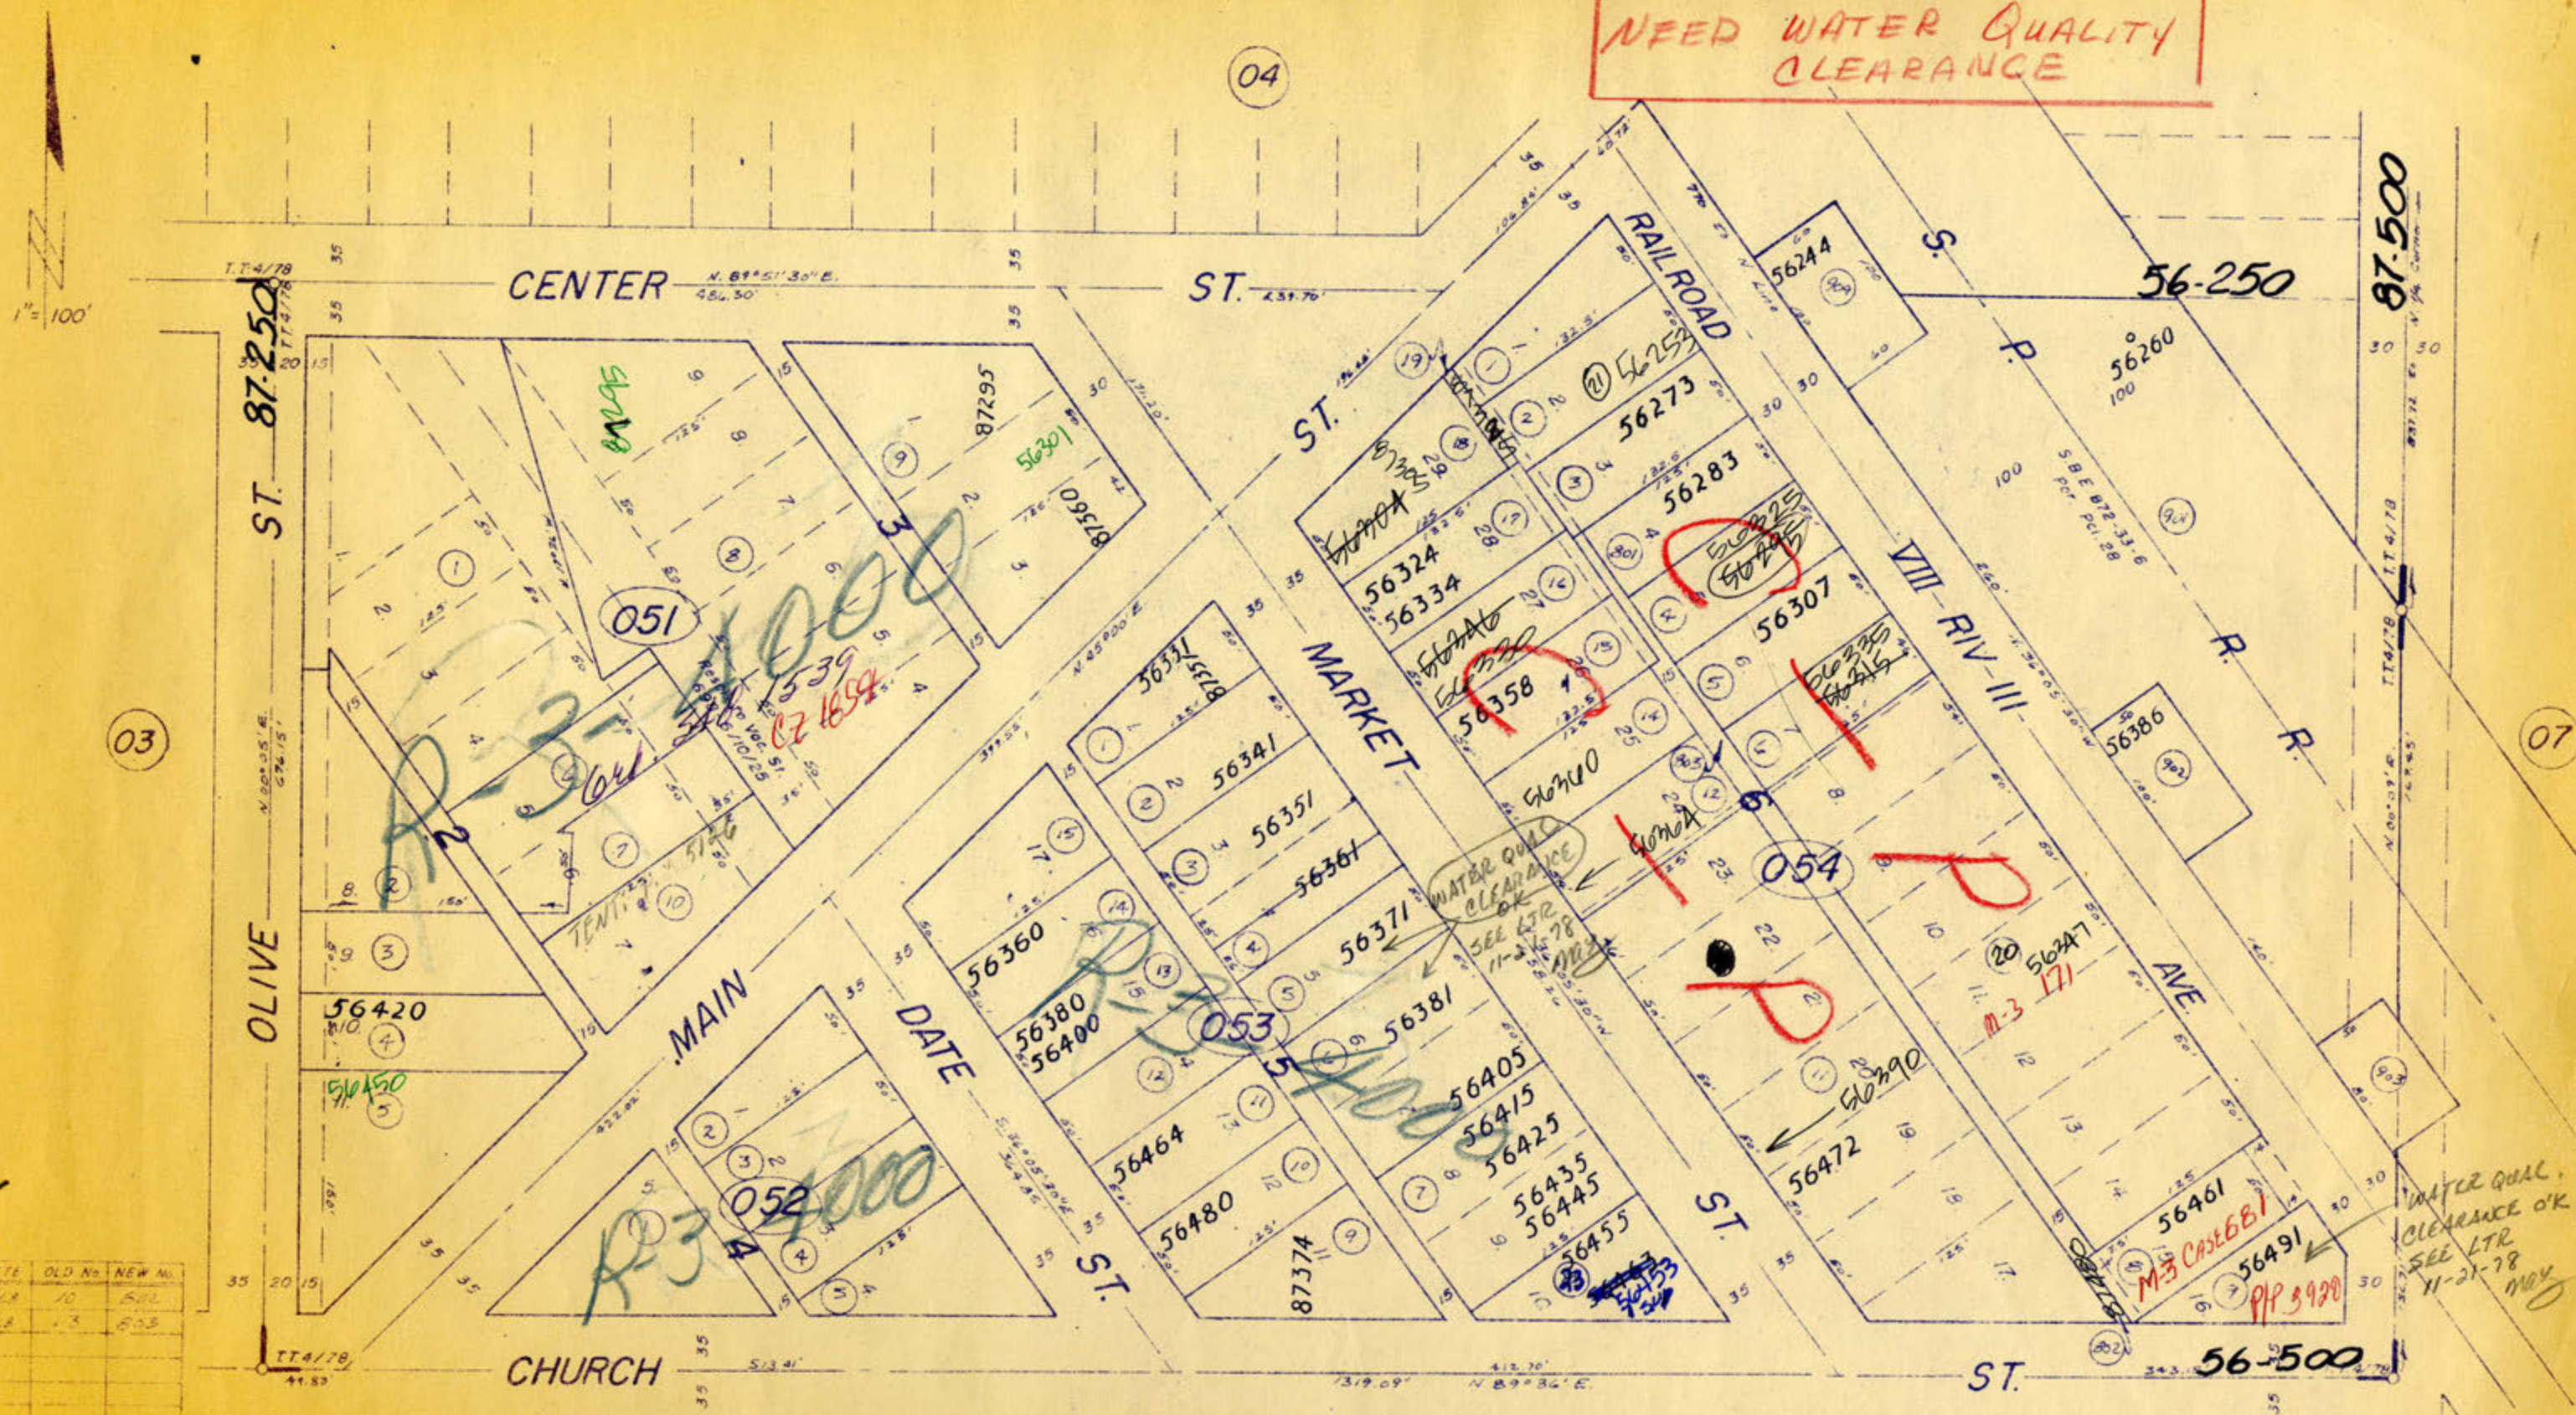

DATE	OLD No.	NEW No.
2/28	10	802
2/28	13	803

Thermal Townsite - M.B. 4/78 - Subdivision NW⁴ Sec. 22.
DATA: R.S. 11/31, M.B. 4/78, B of L.M. - Topo. (C-2N-239). S.B.E. 872-33-6, Per. Pct 20;
State Hwy VIII - RIV - III R/W; Co. Rd. Maps.

FEBRUARY 1967

ASSESSOR'S MAP BK 757 PG. 05
RIVERSIDE COUNTY, CALIF.

LOT LINE ADJUSTMENT BUSBY AND SPIRO LAND SURVEYING

LLA #3459

N87°36'00"E 1319.05

(N87°36'00"E

CHURCH 1259.05

Spiro Land
Surveying
18 Basswood
Riverside, CA 92504
Owner "A":
Housing Authority of the
County of Riverside
APN: 757-061-02, 15, 19, 20
Owner "B":
Coachella Valley Unified
School District
APN: 757-061-11, 16




Michael C. Spiro

EXHIBIT NO. A
LLA CASE NO. 3459



NTS

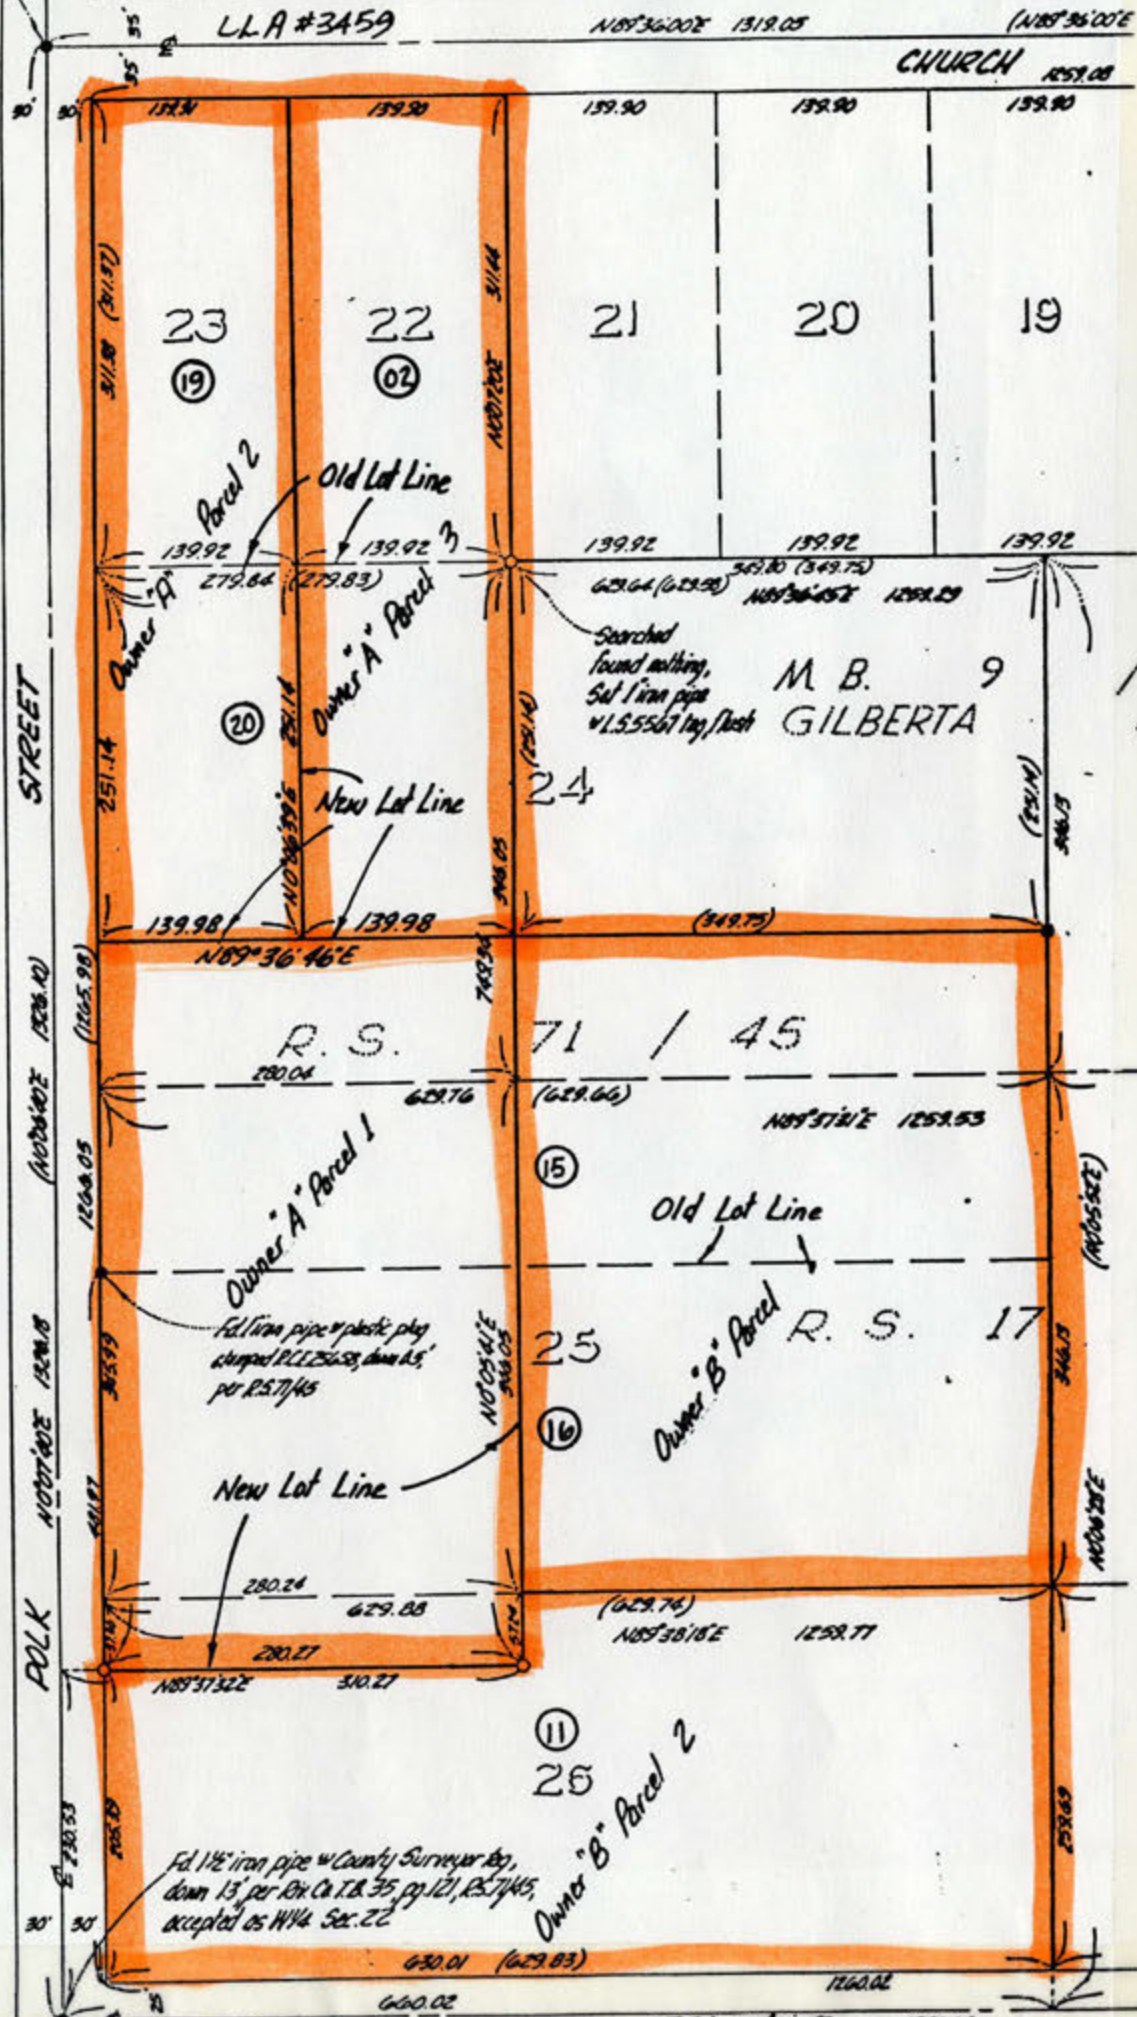

757-06


25-40

T. C. A. 5850

S², NW⁴, SEC. 22, T. 6 S., R. 8 E

THIS MAP IS FOR
ASSESSMENT PURPOSES ONLY

MSC
48.3267
CZ-5789
12-18-90

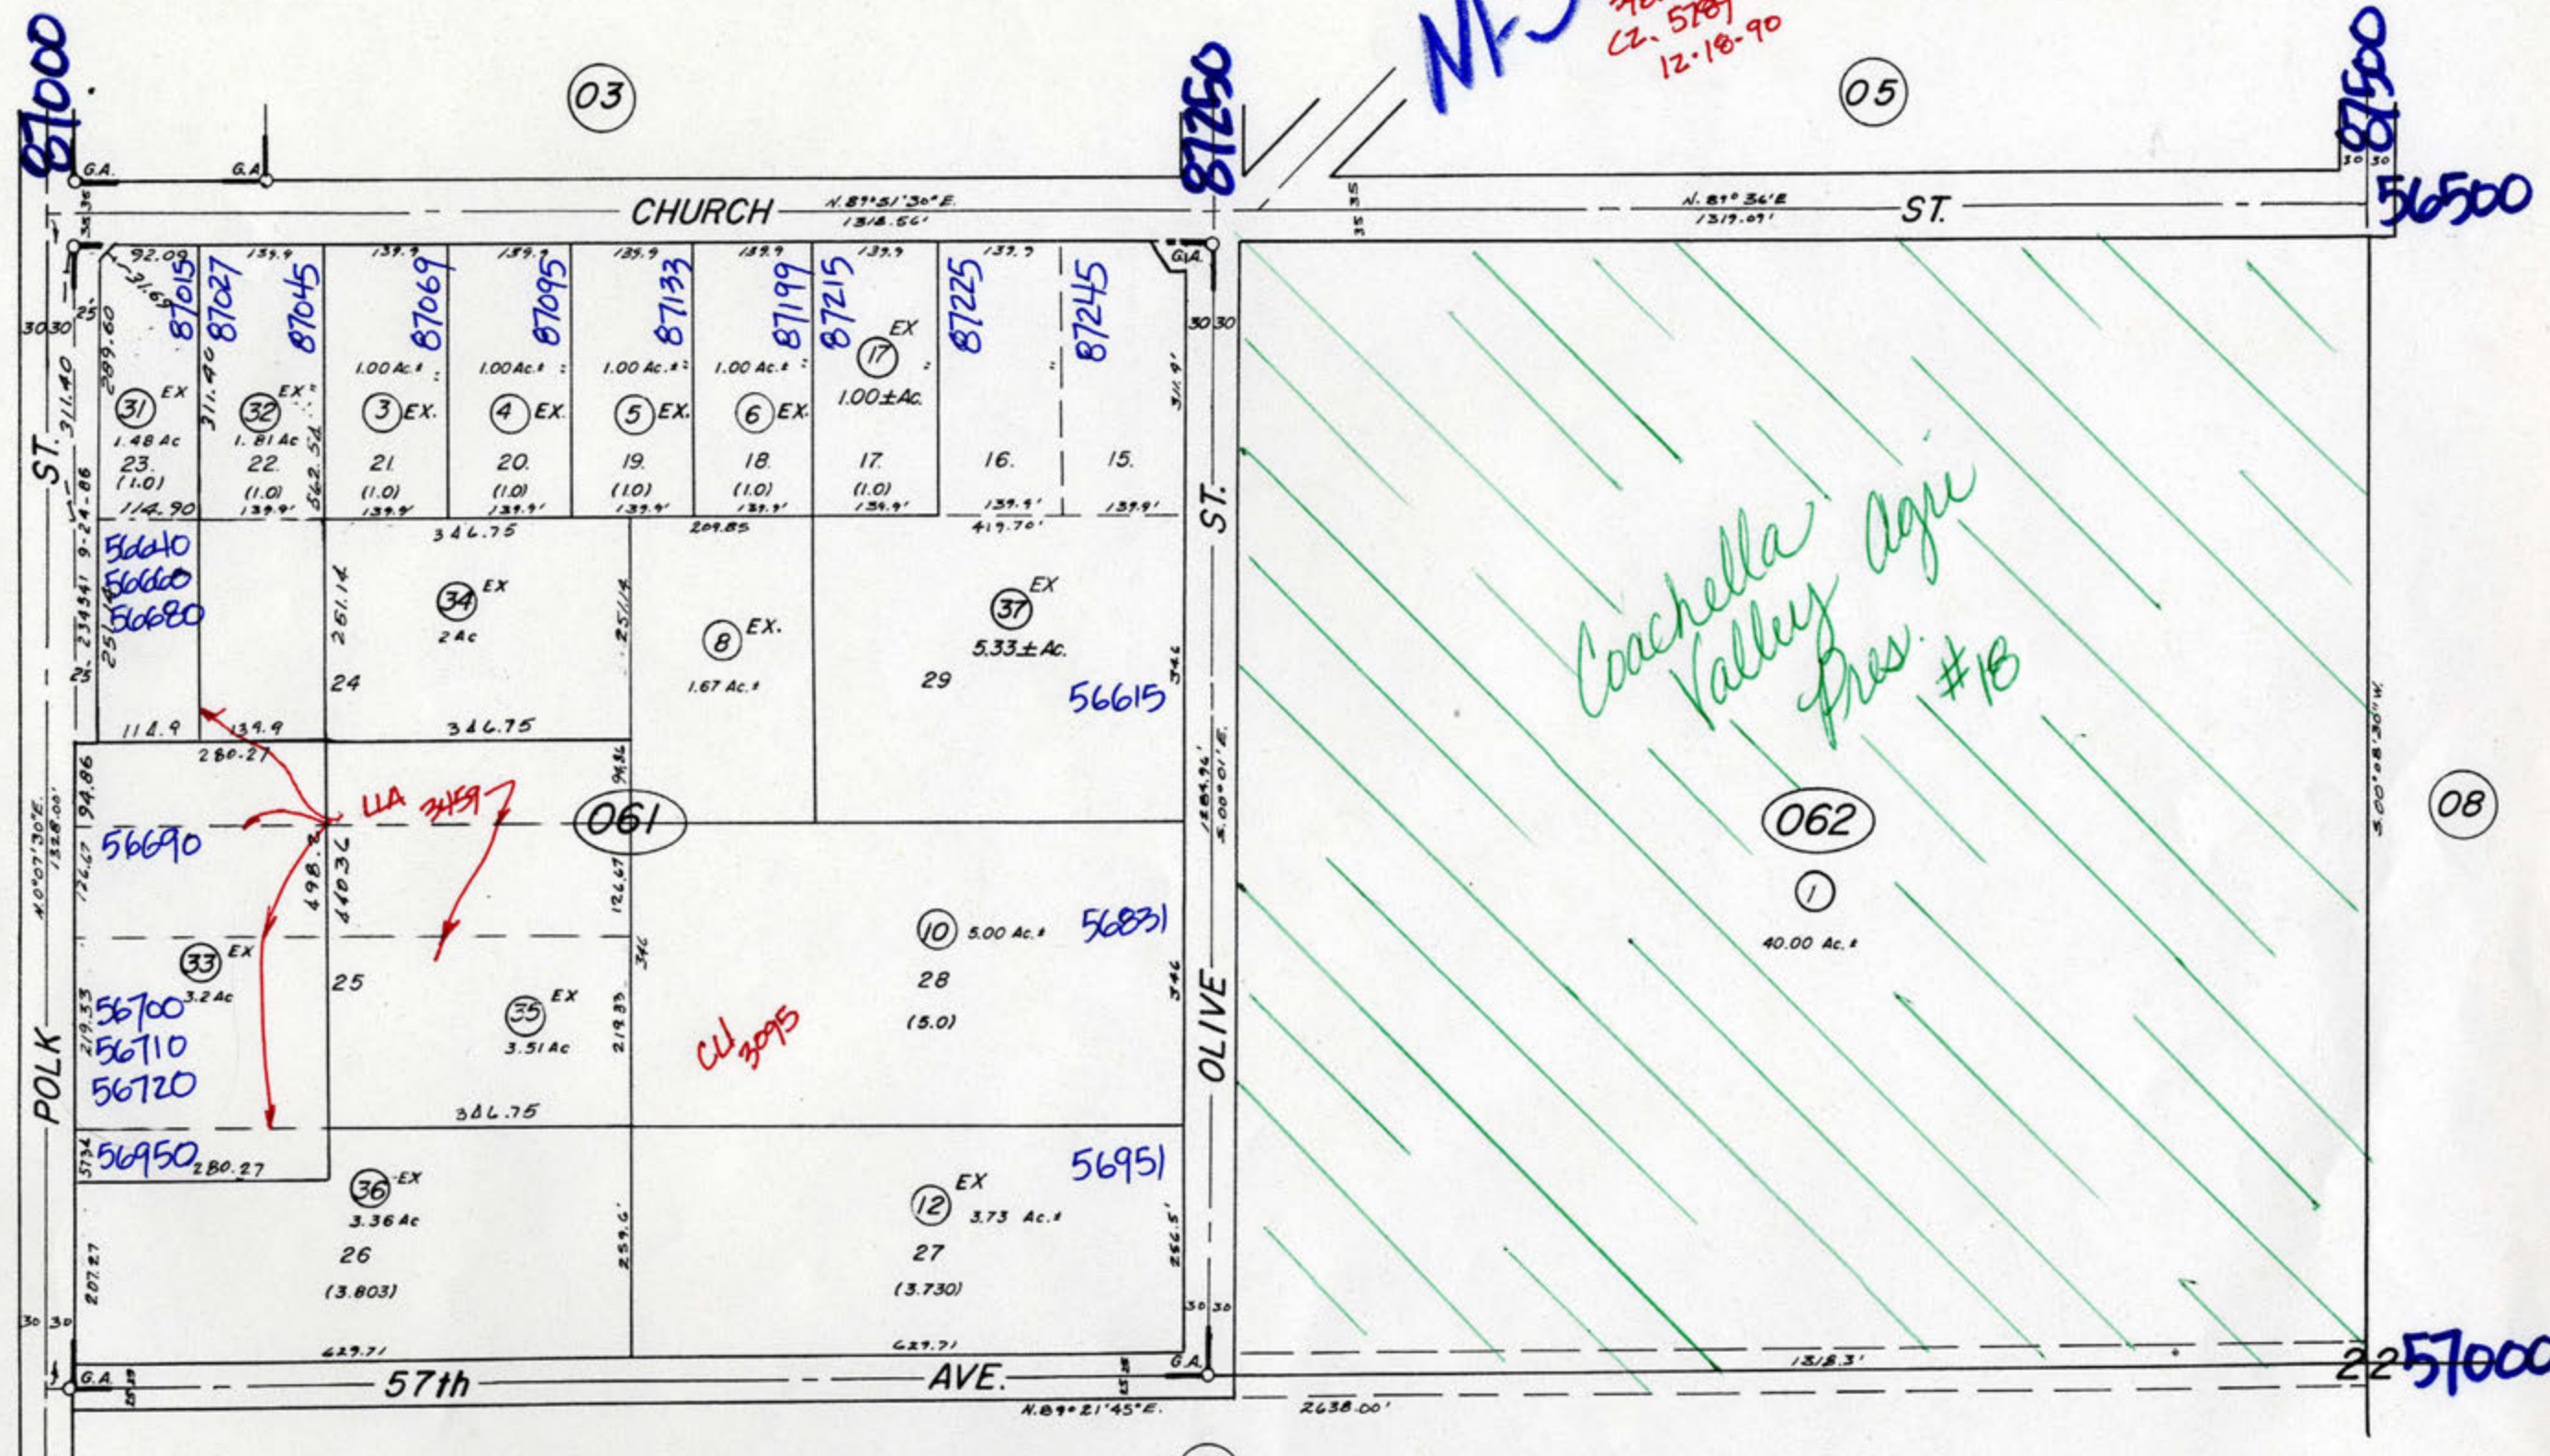

759
07

DATE	OLD NO	NEW NO
4-91	13, 25, 27 23, 21	061-30
2-92	061-29	31-33
"	061-30	34-36
1/93	061-18	37, ST.

DATE	OLD No.	NEW No.
1/68	7	13
1/68	7	14
1/68	9	15
1/68	9	16
11-86	1	19, ST.
"	14	20, ST.
4-91	11	21, 22
"	16	23, 24
"	15	25, 26
"	20	27, 28
"	22, 24, 26 28, 19, 2	061-29

Gilberta Acres - M.B. 9/21- Por. of Subdivision of NW⁴, SEC. 22.

DATA: Gov't. Plat, R.S. 17/18, B. of L. M.-Topo. (C-2N-239), Co. Rd. Maps.
R.S. 71/45, R.S. 91/89


60' Rd. per inst.
32692 4/59

FEBRUARY 1967

ASSESSOR'S MAP BK. 757 PG. 06
RIVERSIDE COUNTY, CALIF.

CA 9/97

Clearance Req'd.
(WEST OF FLOOD CHANNEL)

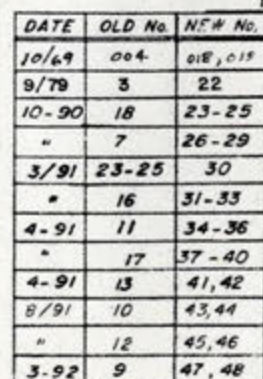


DATE	OLD NO	NEW NO
3-92	6,33, 36,	
	38, 39, 42	51
	43, 46, 48	
	18	
12/92	14	49, HWY
4-92	30	50, HWY
"	5	54, HWY

60' Rds. per inst.
32692 4/59

FEBRUARY 1967

ASSESSOR'S MAP BK. 757 PG. 07
RIVERSIDE COUNTY, CALIF.

CA
9/97

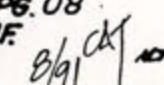

ALL IN
REDEVELOPMENT
PLAN PROTECT
No. 4

[illegible]

DATA: GOV'T PLAT; RS 17/18; STATE HWY VIII - RIV - III; CVCWD Stormwater Channel R/W; Co. Rd Maps;
S.B.E. 872-33-6R, Por. Pcl 29, 872-33-6, Por. Pcl 12,

FEBRUARY 1967


ASSESSOR'S MAP BK.757 PG.09
RIVERSIDE COUNTY, CALIF.

757-10

T. C. A. 058-047
058-049
058-085

N², NW⁴, SEC. 23, T.6S, R.8E.

THIS MAP IS FOR
ASSESSMENT PURPOSES ONLY

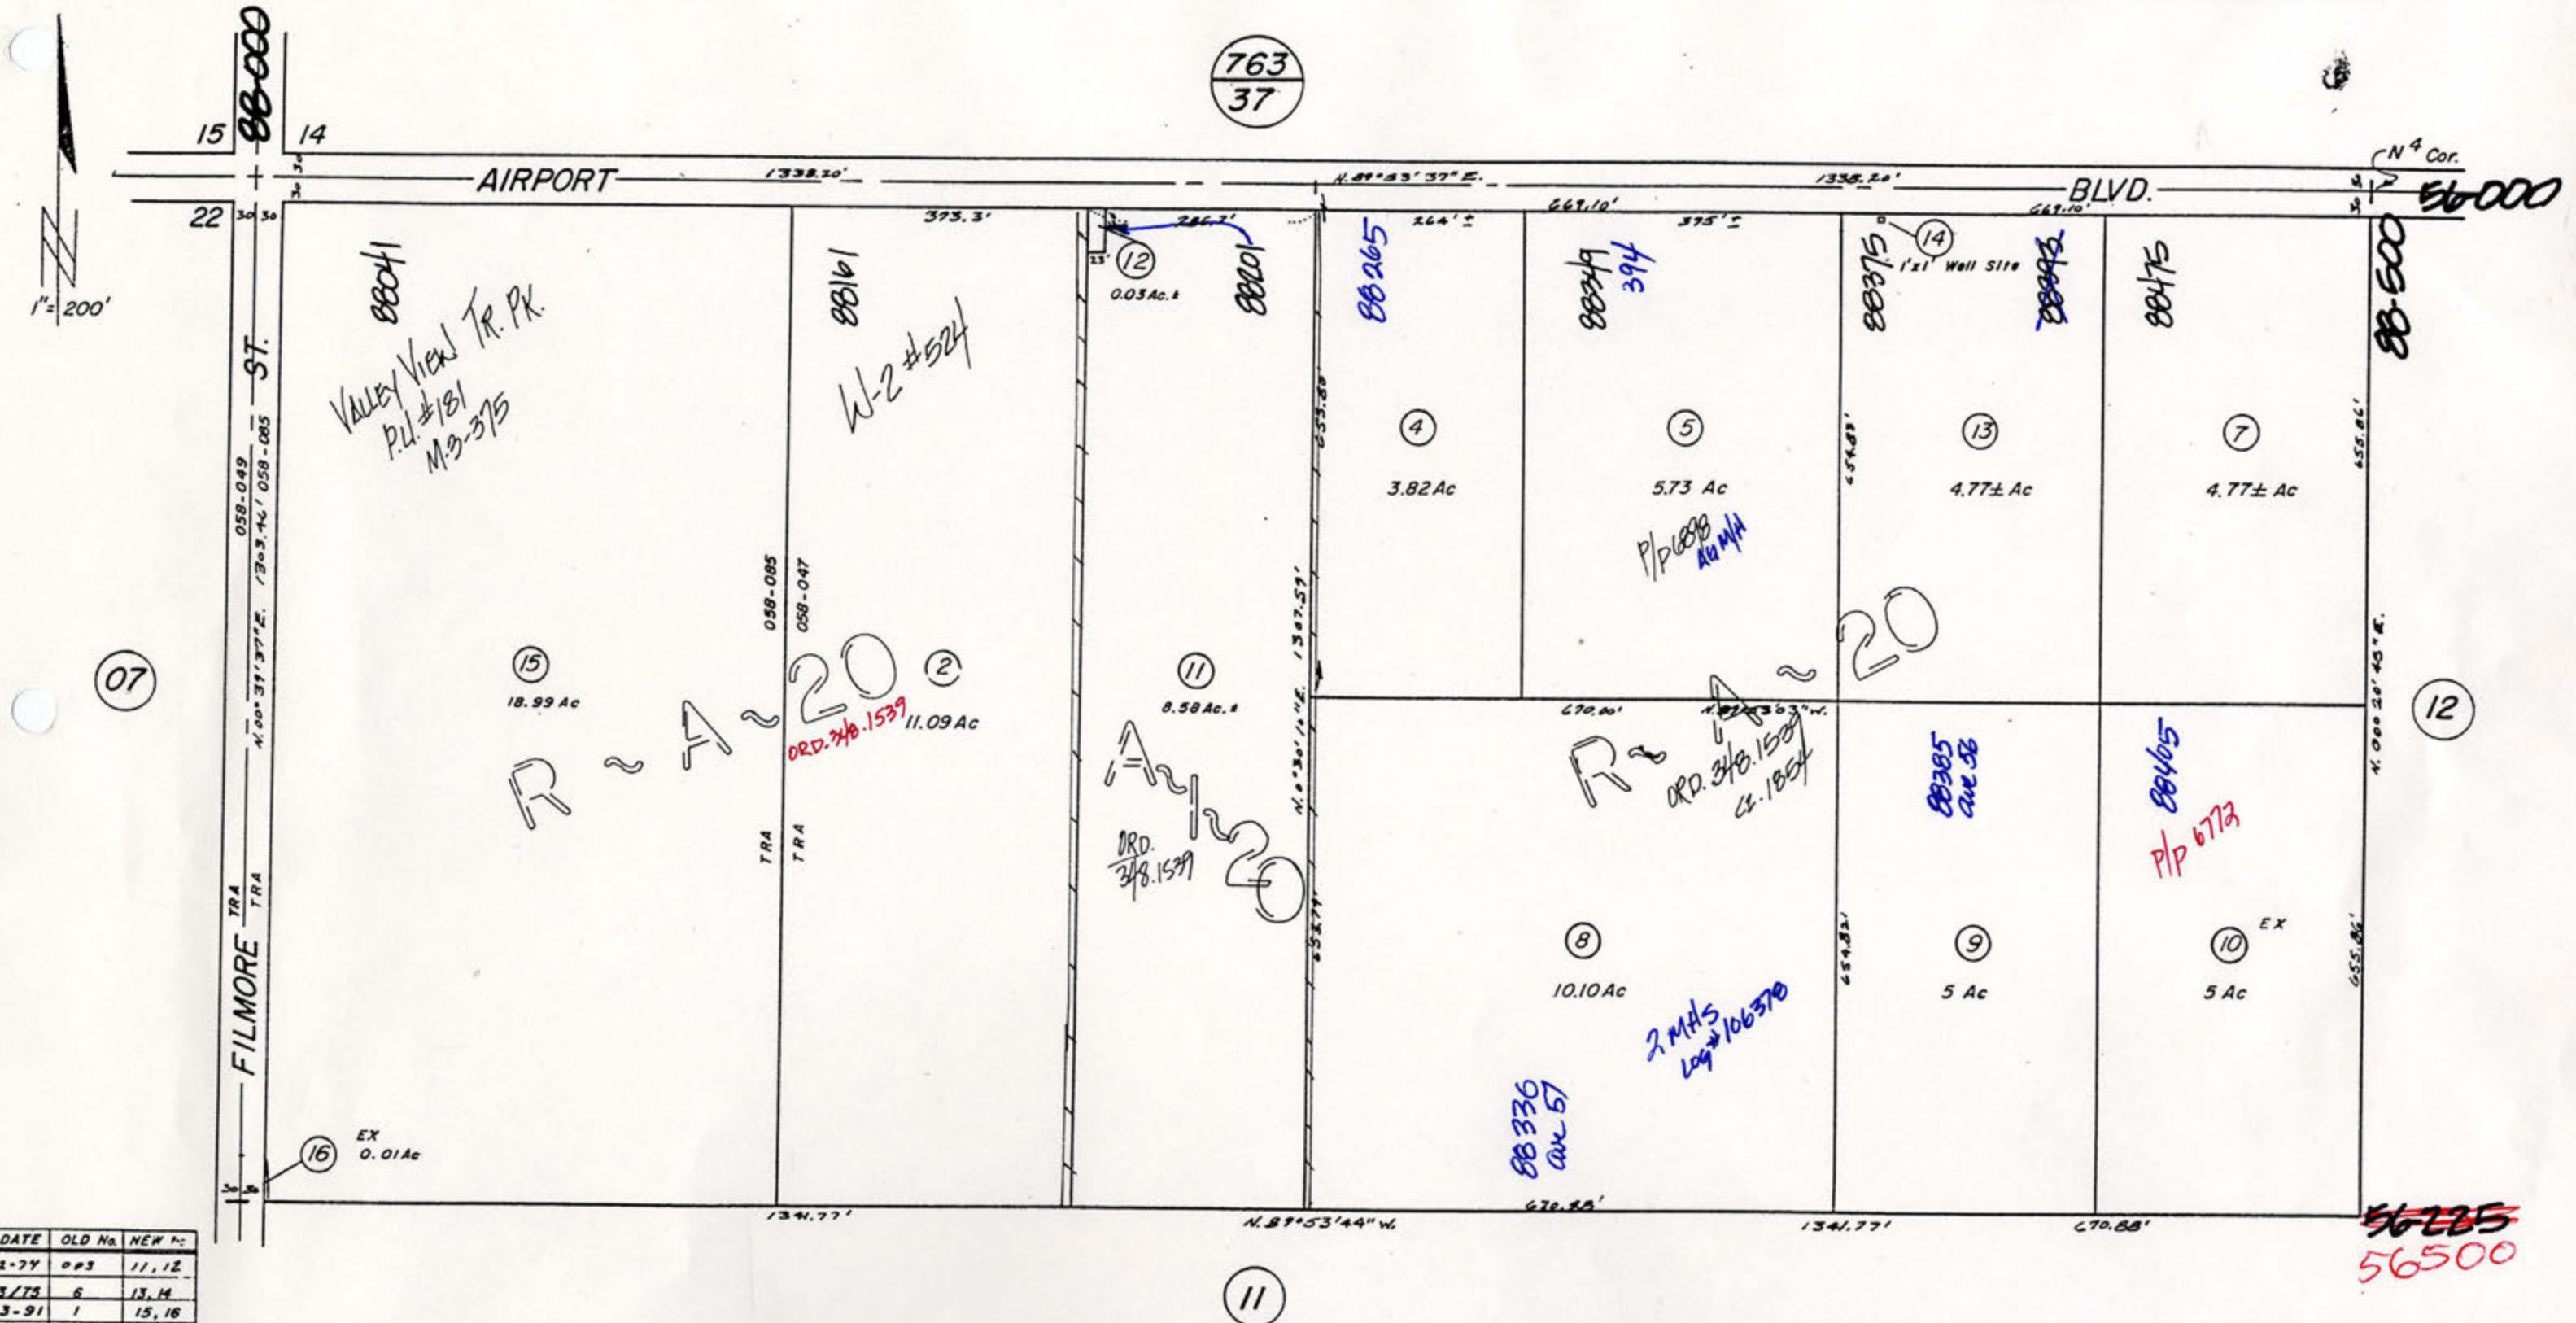

DATA: Gov't. Plat; R.S. 48/21; Co. Rd. Maps.

60' Rds. per inst.
32692 4/59

FEBRUARY 1967

ASSESSOR'S MAP BK. 757 PG. 10
RIVERSIDE COUNTY, CALIF.

T. C. A. 058-047
058-049
058-085


S², NW⁴, SEC. 23, T. 6S, R. 8E.

THIS MAP IS FOR
ASSESSMENT PURPOSES ONLY



08

13

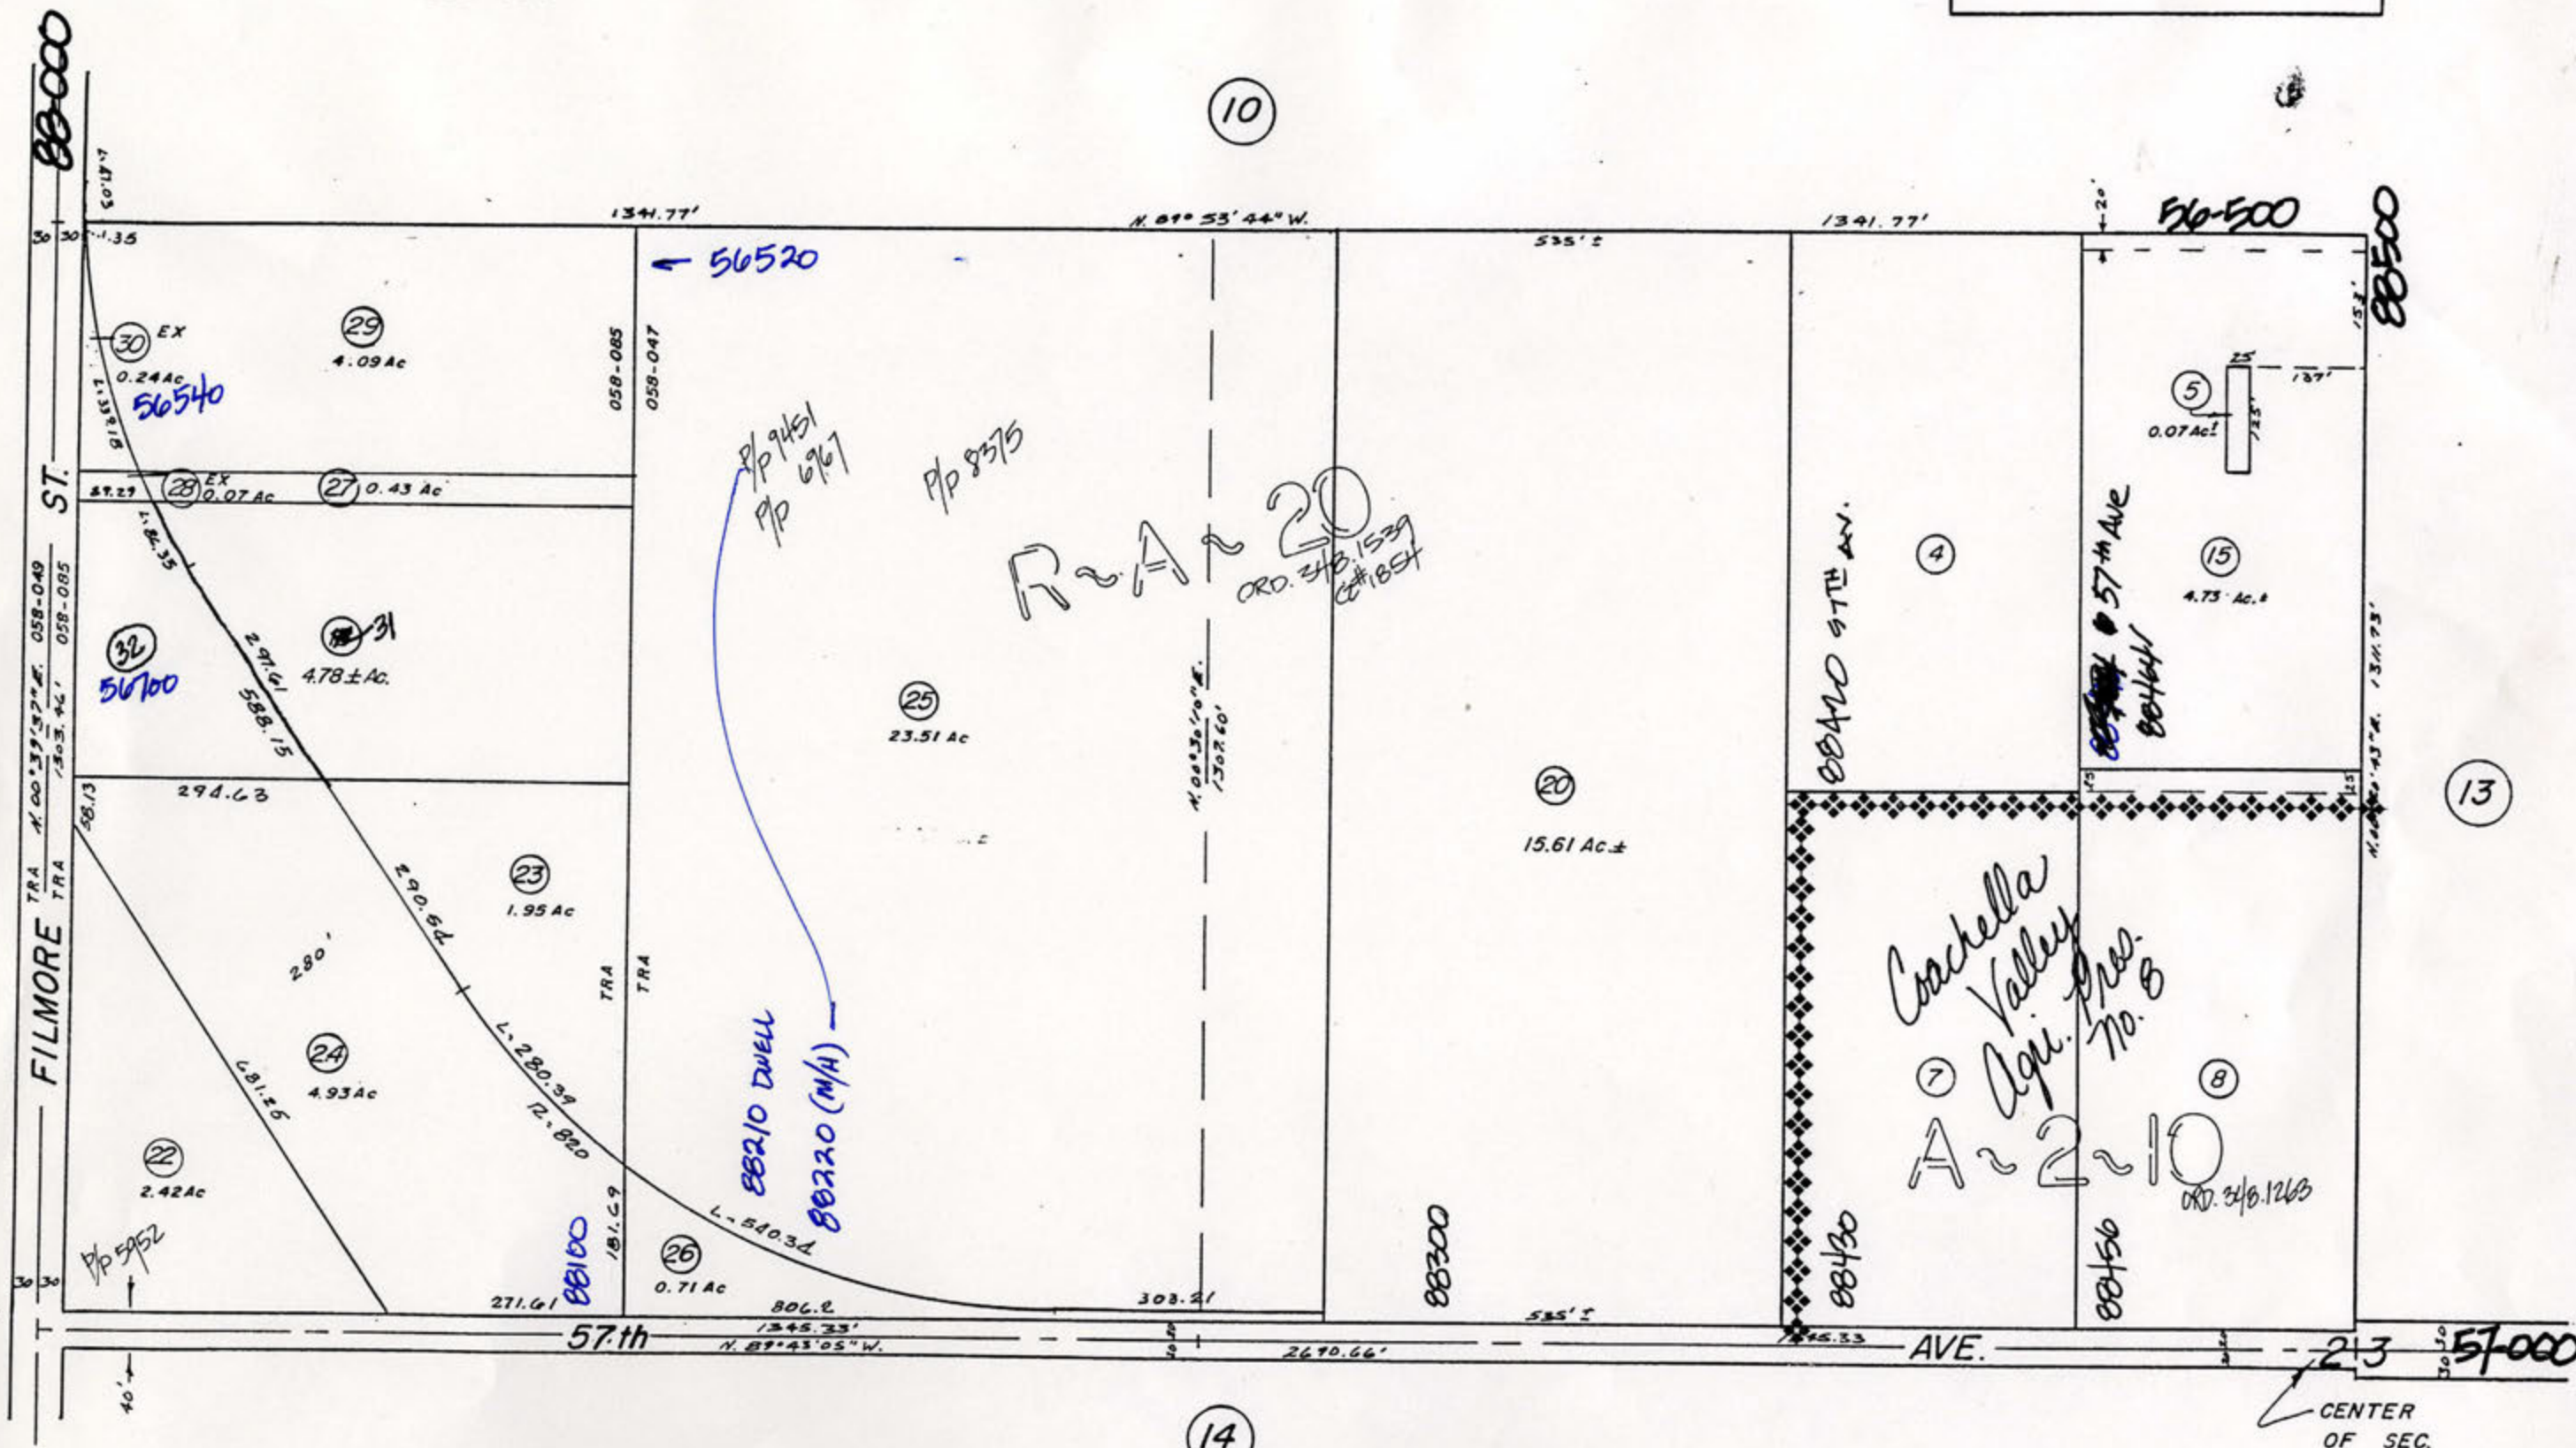

DATA: R.S. 48/21; Dept. of Interior Topo. Map. C - 2N-161; Co. Rd. Maps;

60' Rd. per inst.
32692 4/59

FEBRUARY 1967

ASSESSOR'S MAP BK. 757 PG. 11
RIVERSIDE COUNTY, CALIF.

9/9/07

N², NE⁴, SEC. 23, T. 6 S., R. 8 E.

BK.
763

$\Omega N^4 \text{ Cor.}$

AIRPORT

-BLVD.

56.00

13

82

७.

80

1

100

1

56125-

56265

56.500

Coachella Valley Agricultural Reserve No. 8

Amendment No. 1 Map 119 8-7-73

Ord. 348.1539
171854

1539
21854
Coachella Valley
Agri. (2)
Preserve
No. 6

A-2-20

①

②

(13)

$$I'' = 200$$

DATA R S 48/21; Dept of Interior - Topo. C-2N-161; Co. Rd. Maps;

FEBRUARY 1967

ASSESSOR'S MAP BK.757 PG.12
RIVERSIDE COUNTY, CALIF. *NET*

S², NE⁴, SEC. 23, T. 6 S., R. 8 E.

88-500

12

56-500

89-000

57-

'321.20'

מדינת ישראל

30.3

(18)

(11)

$400^{\circ} 20' 43'' E. \quad 1311.73'$

 $2+3$

-57th

2691.8'
N 89° 43' 05" W

- AVE

57-000

16

[illegible]

CENTER
OF SEC.

DATA: R.S. 48/21; Dept. of Interior - Topo. C-2N-161; Co. Rd. Maps.

60' Rd per inst
32692 4/59

FEBRUARY 1967

ASSESSOR'S MAP BK. 757 PG. 13
RIVERSIDE COUNTY, CALIF.

757-14

25-39-2

T.R. A. 058-047
058-085

N², SW⁴, SEC. 23, T.6S, R.8E.

THIS MAP IS FOR
ASSESSMENT PURPOSES ONLY



DATE	OLD NO	NEW NO
12-90	5	39, 40
4-91	28	41, 42
"	35	43, 44
"	31	45, 46
"	32	47, 48
"	10	49, 50
8/91	34	51, 52
6/92	39, 40	53
"	53	54, 55
"	54	56, 57
"	41	58, 59, 60
"	26	61

DATE	OLD No.	NEW No.
8/69	107	015, 016
1/72	8	18, 19
1/72	17	20, 21
10/72	18	22, 23
10/72	19	24, 25
10/72	01	26
8/74	22	28, 29
10/74	24	30, 31
1/75	3	31, 32
5/75	27	33, 34
12-82	15	35-36
10-90	11	37, 38

DATA: GOV'T. PLAT, R.S. 14/1, 4/58; Co. Rd. Maps,

FEBRUARY 1967

P.M. 110/42 Parcel Map 17611

60' Rd. per inst.
32692 4/59

ASSESSOR'S MAP BK. 757 PG. 14
RIVERSIDE COUNTY, CALIF.

CHT
9/92



DATE	OLD NO	NEW NO
4 - 91	2	34, 35
10/91	16	36, 37
8/93	31	37, 38
"	30	37
"	33	37
"	22	38
8/93	35	37


DATE	OLD No	NEW No
3/68	5	11
3/68	5	12
9/75	4, 11	13
7/80	8	17, 18
12/80	17, 18	19
4/82	19	20, ST.
5/82	12	21, 22
5/82	21	23, 24
5/82	10, 2	25, 26
11-89	13, 24	27
3-91	9	28-30
"	25	31-33

DATA: RS. 4/58; S.B.E 872-33-6, Pcl.13, 872-33-7A, Pcl. 5; State Hwy. Maps - VIII-RIV-III, C.V.S.W.D. Stormwater Channel R/W Maps; Co. Rd. Maps.


FEBRUARY 1967


60' Rds. per inst.
32692 4/59

ASSESSOR'S MAP BK.757 PG.15
RIVERSIDE COUNTY, CALIF. *not*

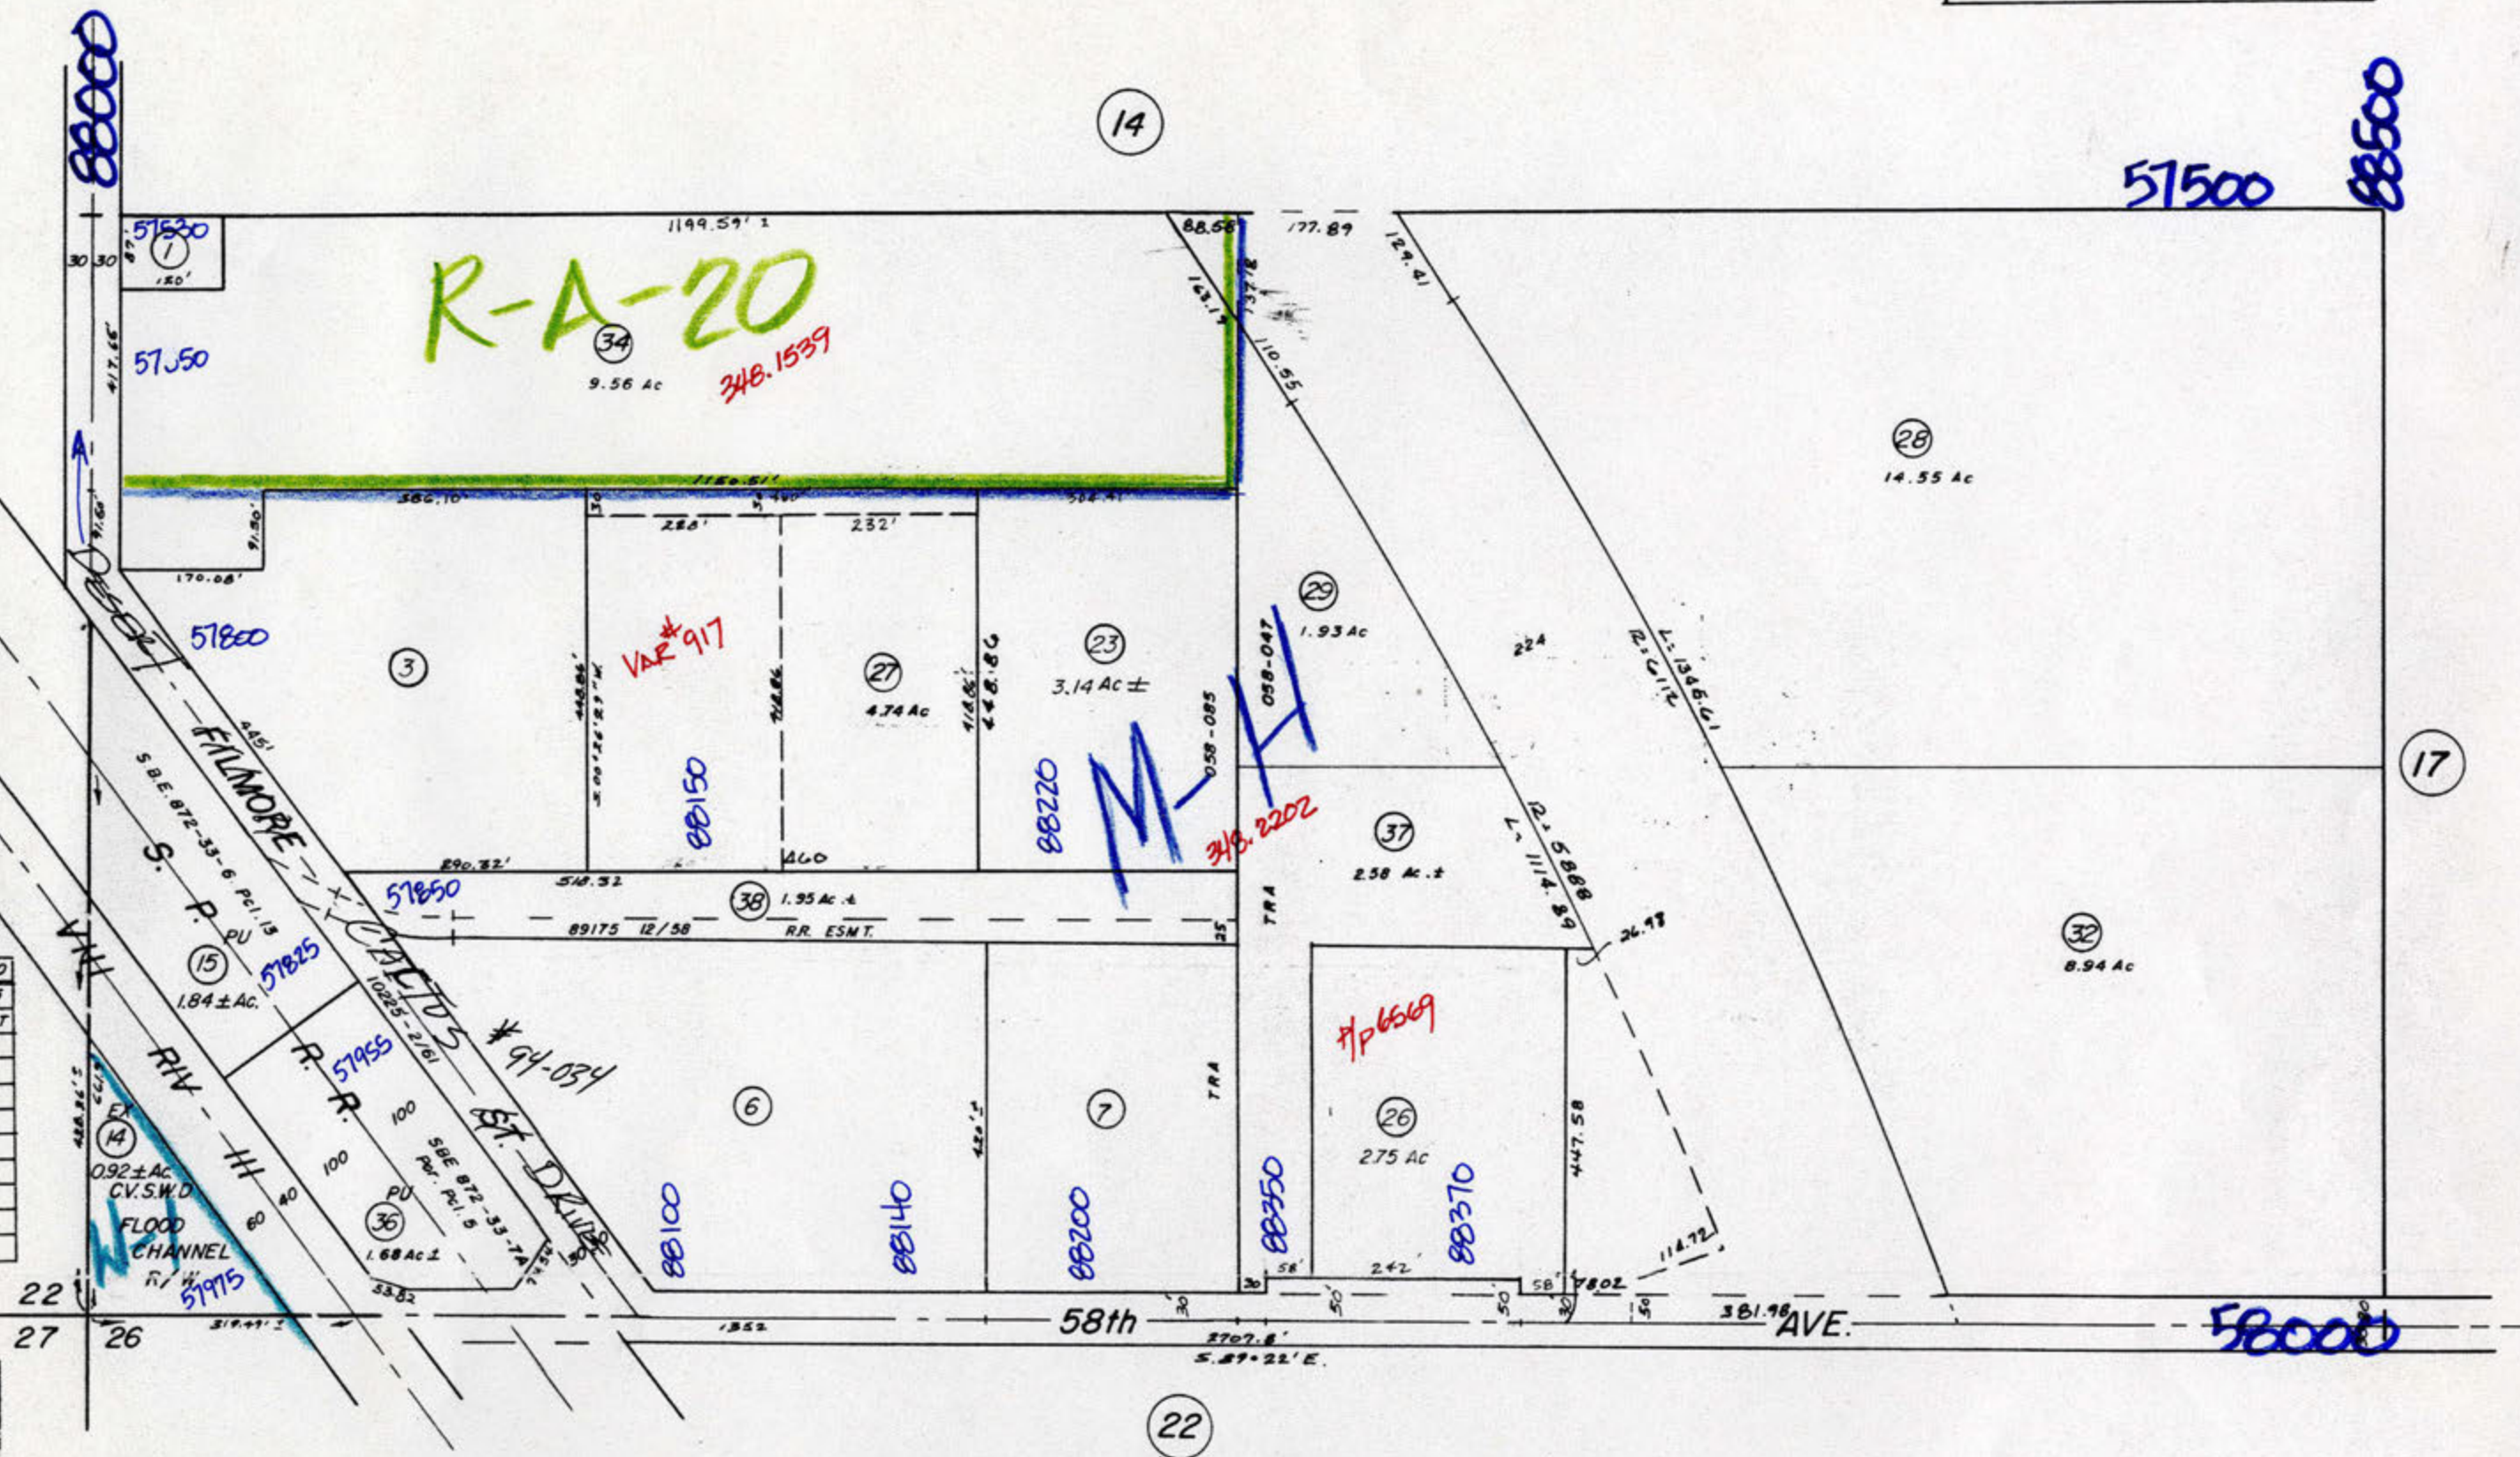

N², SE⁴, SEC. 23, T. 6 S., R. 8 E.

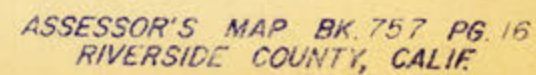

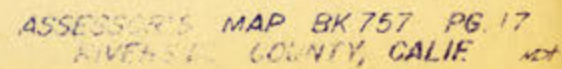



FEBRUARY 1967

ASSESSOR'S MAP BK. 757 PG. 18
RIVERSIDE COUNTY, CALIF.

[illegible]


ASSESSOR'S MAP BK. 757 PG. 19
RIVERSIDE COUNTY, CALIF.

FEBRUARY 1967

25-45

N², SEC. 27, T. 6 S., R. 8 E.

IN
REDEVELOPMENT
PLAN PROJECT
No. 4

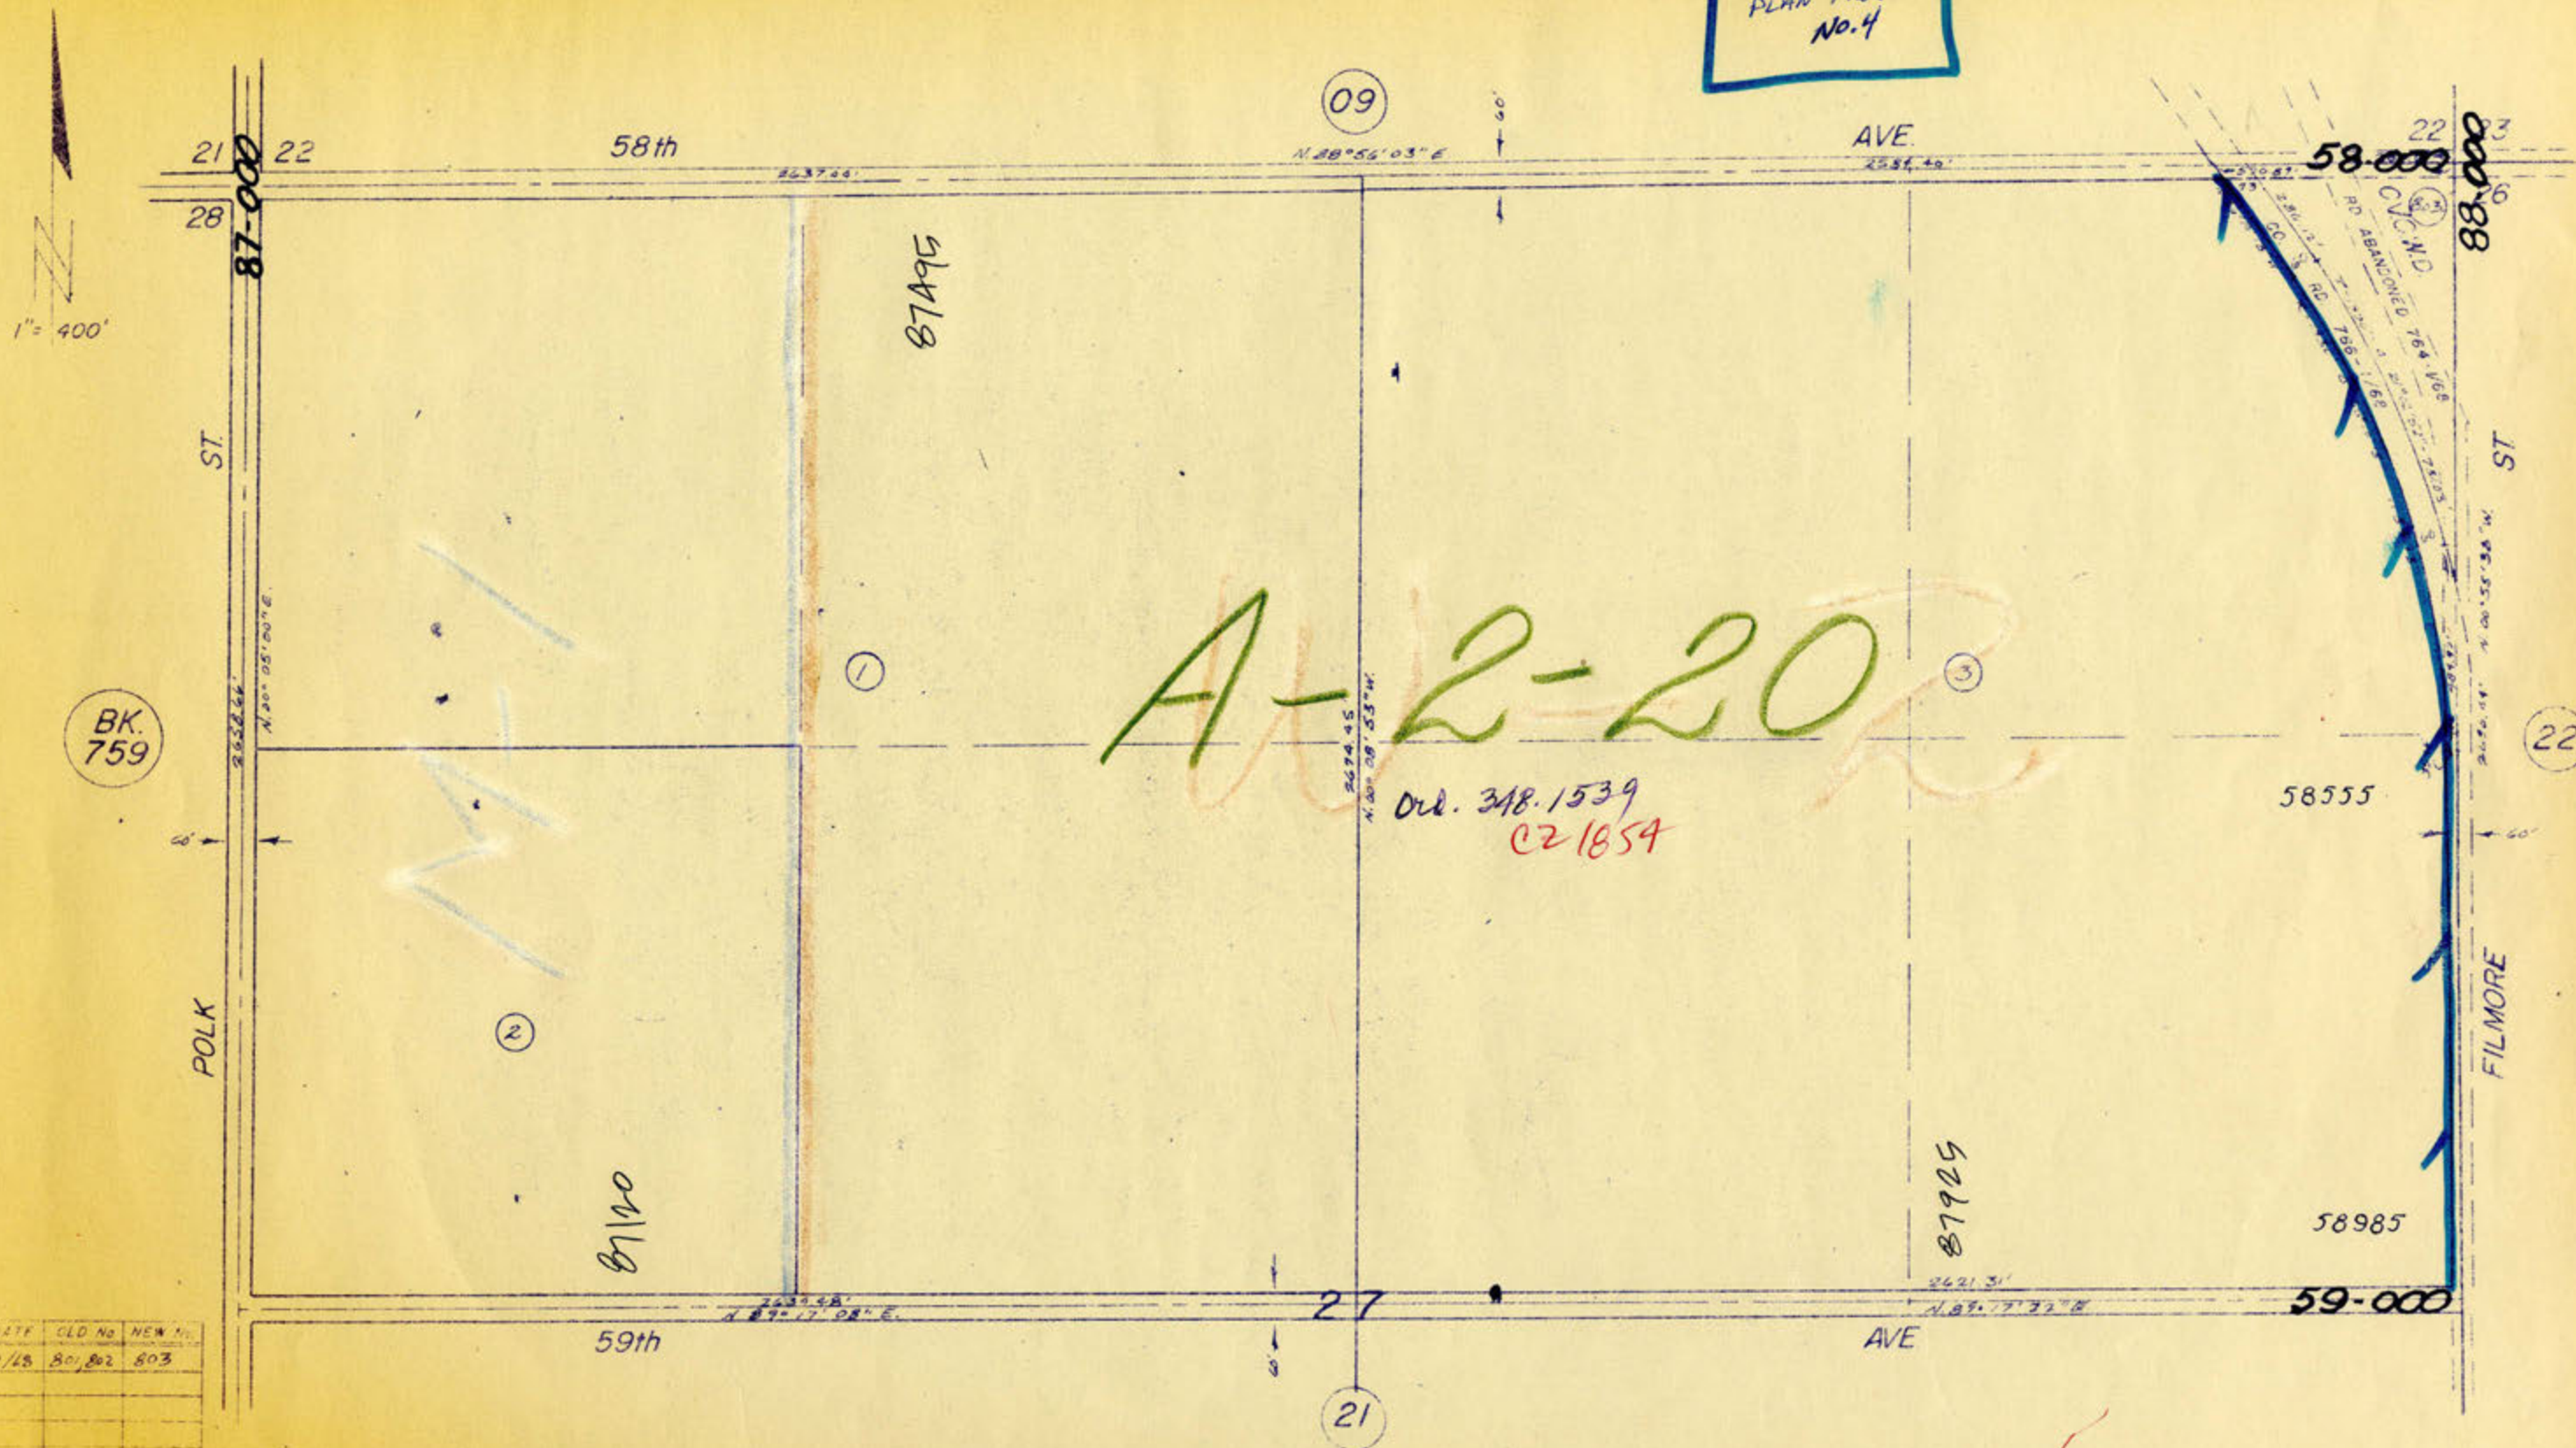
[illegible]

DATA, Co. Sur. Office Map 700-V; CVCWD Stormwater Channel Maps; Co. Rd. Maps

FEBRUARY 1967

ASSESSOR'S MAP BK. 757 PG. 20
RIVERSIDE COUNTY, CALIF.

ALL IN
REDEVELOPMENT
PLAN PROJECT
No. 4

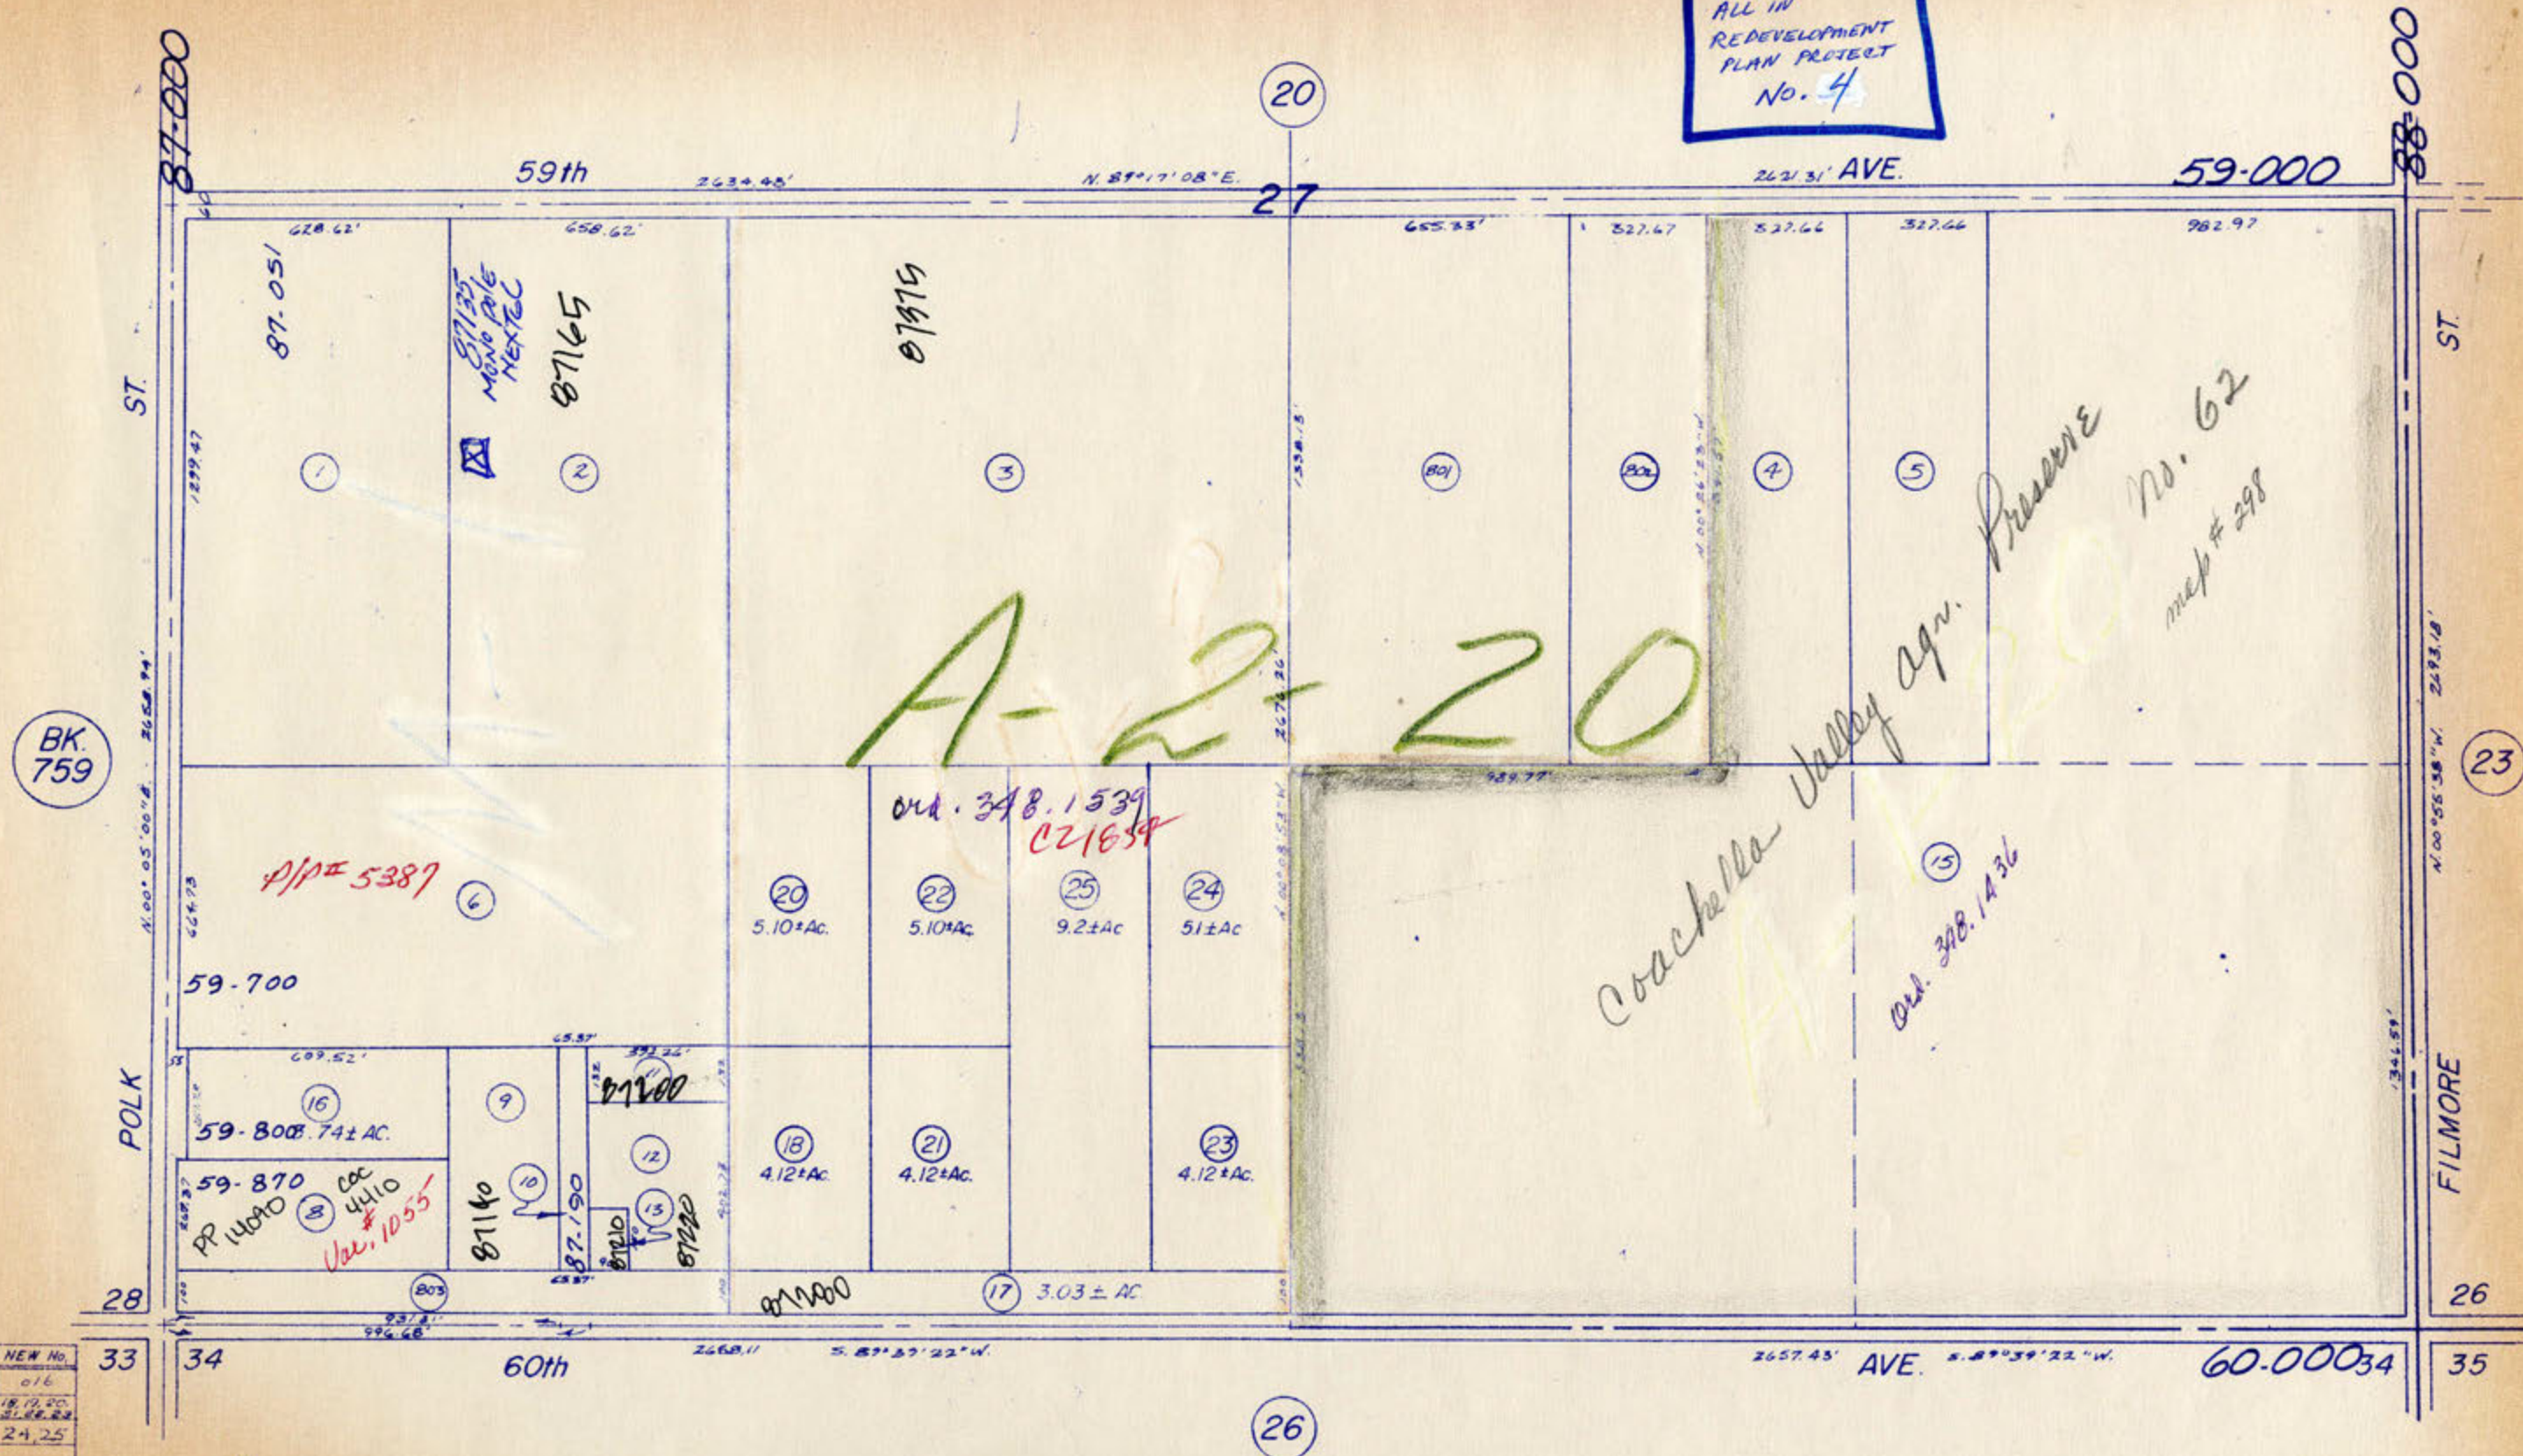[illegible]

DATA: Co. Sur. Office Map 700-V, Ca. Rd. Maps

60' Rds. per inst.
32692 4/59

FEBRUARY 1967

ASSESSOR'S MAP BK.757 PG.21
RIVERSIDE COUNTY, CALIF.


757-22

25-45

T.R. A. 058-047

N², SEC. 26, T. 6 S., R. 8 E.

THIS MAP IS FOR
ASSESSMENT PURPOSES ONLY.

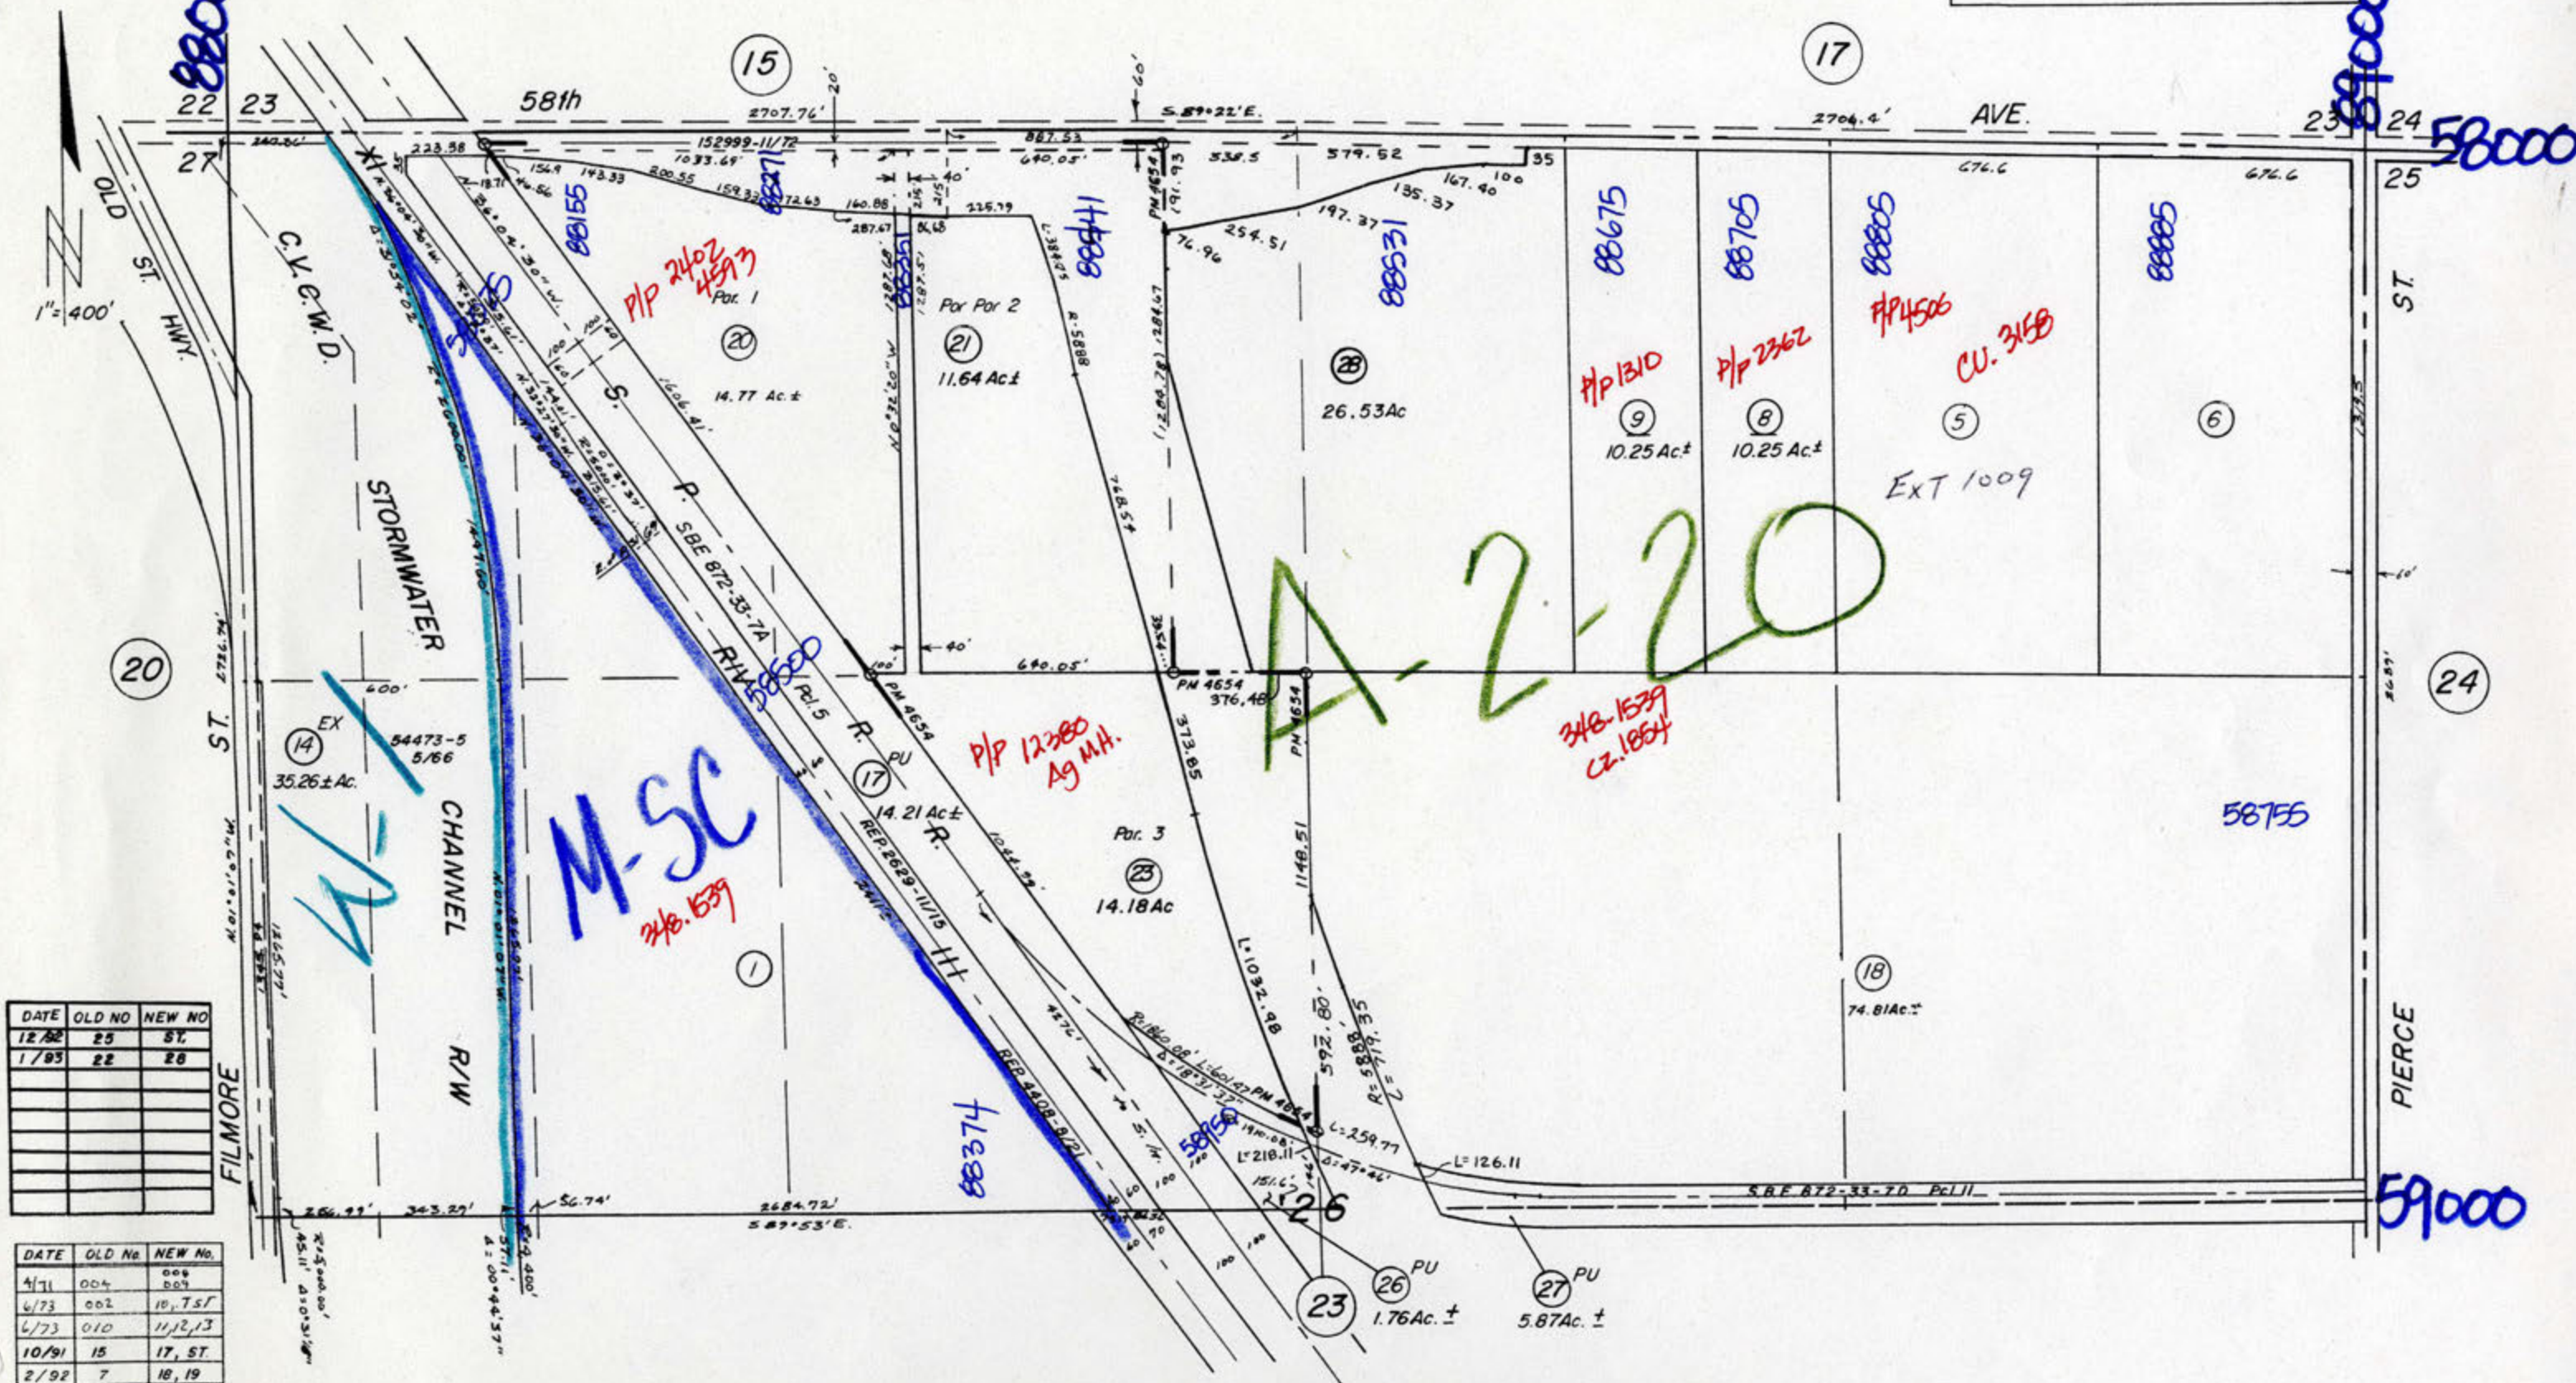

DATE	OLD NO	NEW NO
12/82	25	ST.
1/83	22	28

DATE	OLD No	NEW No.
4/71	004	009
6/73	002	10, 75/
6/73	010	11, 12, 13
10/91	15	17, ST.
2/92	7	18, 19
4/92	11	20, ST.
6/92	12	21, ST.
10/92	3	22, ST.
"	13	23, 24
"	24, 19	25
12/92	16	26, 27, ST

DATA: R.S.4/58, 5/26; U.S. Dept. of Interior - Topo - C-2N-182; C.V.C.W.D. Stormwater Channel R/W Maps; S.B.E. 872-33-7a-Pcl. 5, & 7d.-Pcl. II;
State Hwy. XI-RIV-III (RIV-187-F) R/W Maps; Co. Sur. Maps-26-V & 617-K; D.B. 238 Pgs. 165 & 171; P.M. 6/51 Parcel Map 4654

FEBRUARY 1967

60' Rds. per inst.
32692 4/59

ASSESSOR'S MAP BK. 757 PG. 22
RIVERSIDE COUNTY, CALIF.


cat
9/93






DATA: R.S. 30/72, 10/3; Dept. of Interior-Topo-C-2N-183, Co. Rd. Maps, R.S. 6/16

FEBRUARY 1967

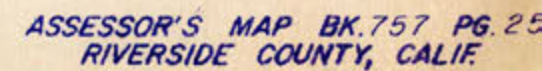

ALL IN
REDEVELOPMENT
PLAN PROJECT
No. 4

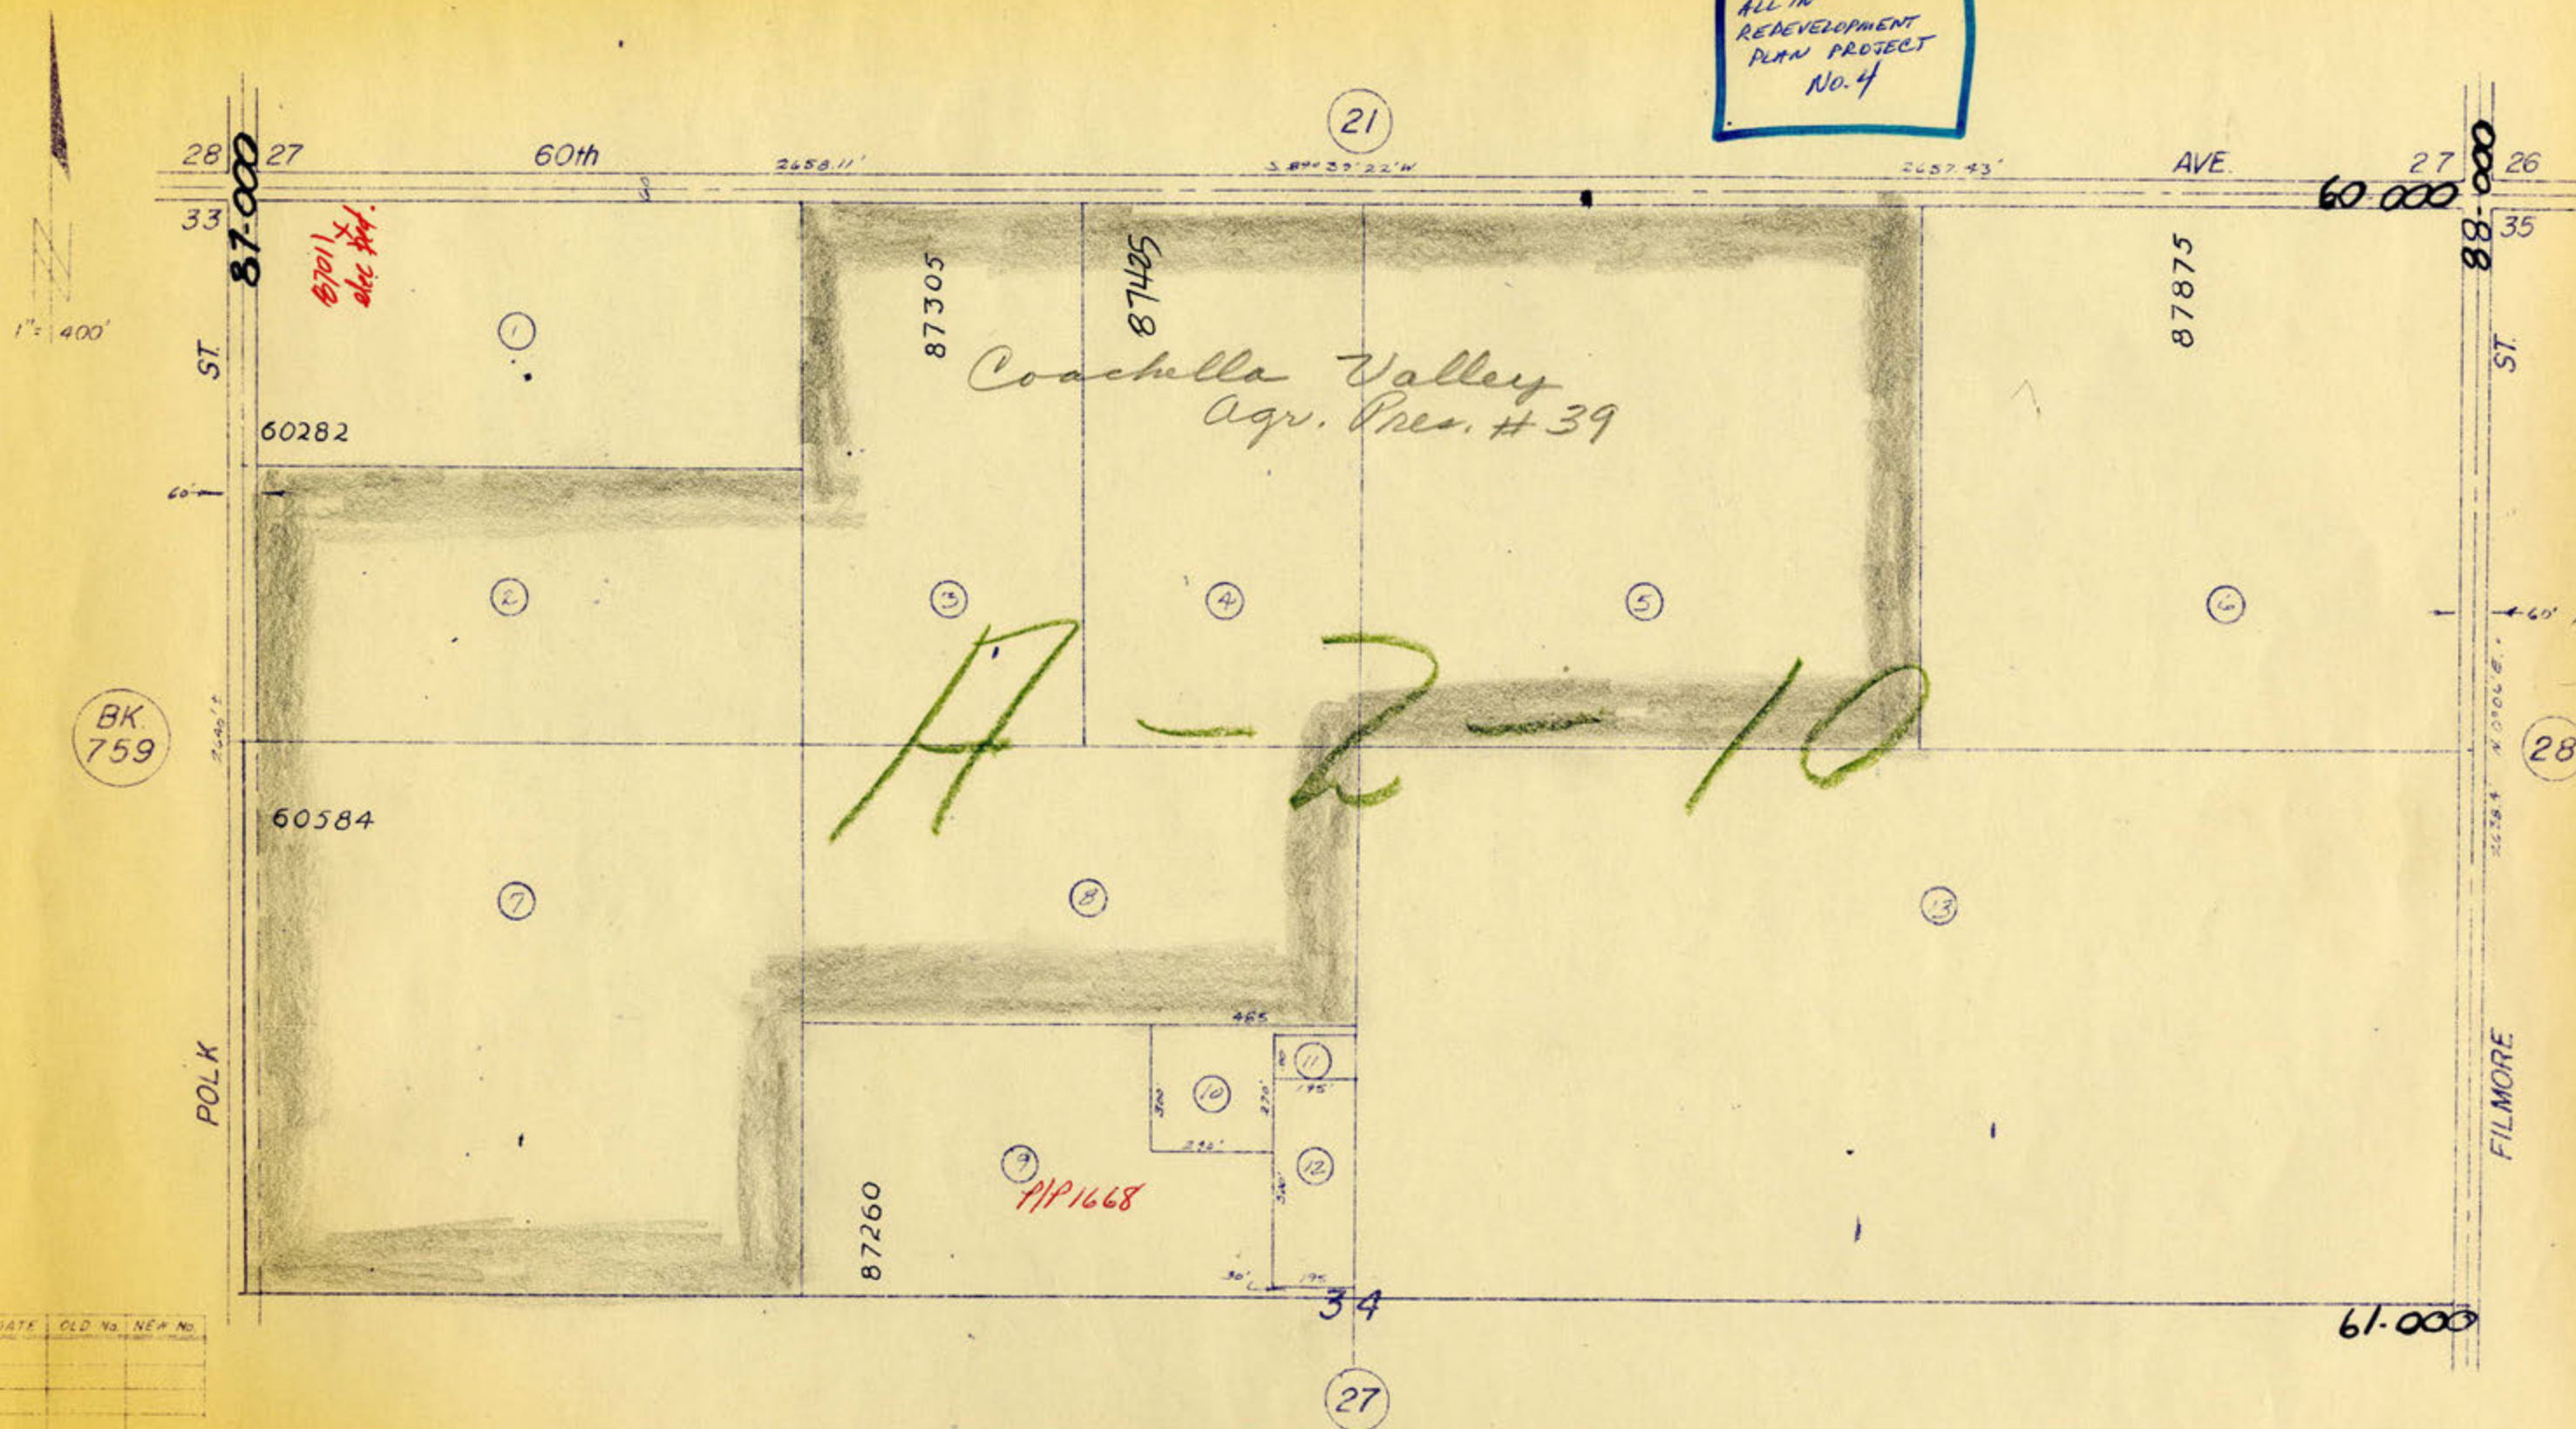[illegible]

757-28

T. C. A. 5847

POR. N² SEC. 35, T.6S, R.8E.IN
REDEVELOPMENT
PLAN PROTECT
NO. 4

(23)

27 26

60th

AVE.

60-000 26 25

34

ST.

88-075

(1)

(19)

C.V.C.W.D.
STORMWATER
CHANNEL

(18)

(22)

39.09 ± Ac.

SEE

MAP

29

SEE

MAP

30

36

ST.

(32)

(26)

FILMORE

60700

(7)

60750

5.00 Ac ±

(23)

18.90 ± AC.

(24)

(21)

092-88

CHANNEL
R/W

(20)

88-450

(12)

88-550

P/P # 1298

(13)

88-630

(14)

(15)

(16)

88-800

(17)

60.995

PIERCE

(33)

AVE. 61-000

61st

(31)

DATE	OLD No.	NEW No.
10/67	3	803
10/67	801, 4	802
10/67	4	18
12/67	2	19
12/67	802	804
3/68	804	805
3/68	11	20
9-5-68	010 805	806
7/68	005, 006	022
4/70	009	023, 024
6/70	018	025, 026

DATA: GL O. Plat-8H; R.S. 4/58, 5/26, C.V.C.W.D. R/W Maps - '21 & '66, Co. Sur. File -123 F, State Hwy. XI-RIV-III Maps, Co. Rd. Maps.

60' Rds. per inst.
32692 4/59

FEBRUARY 1967

ASSESSOR'S MAP BK. 757 PG. 28
RIVERSIDE COUNTY, CALIF.


757-28

T. C. A. 9501

POR. N² SEC. 35, T6S, R.8E.

IN
REDEVELOPMENT
PLAN PROJECT
NO. 4

(23)

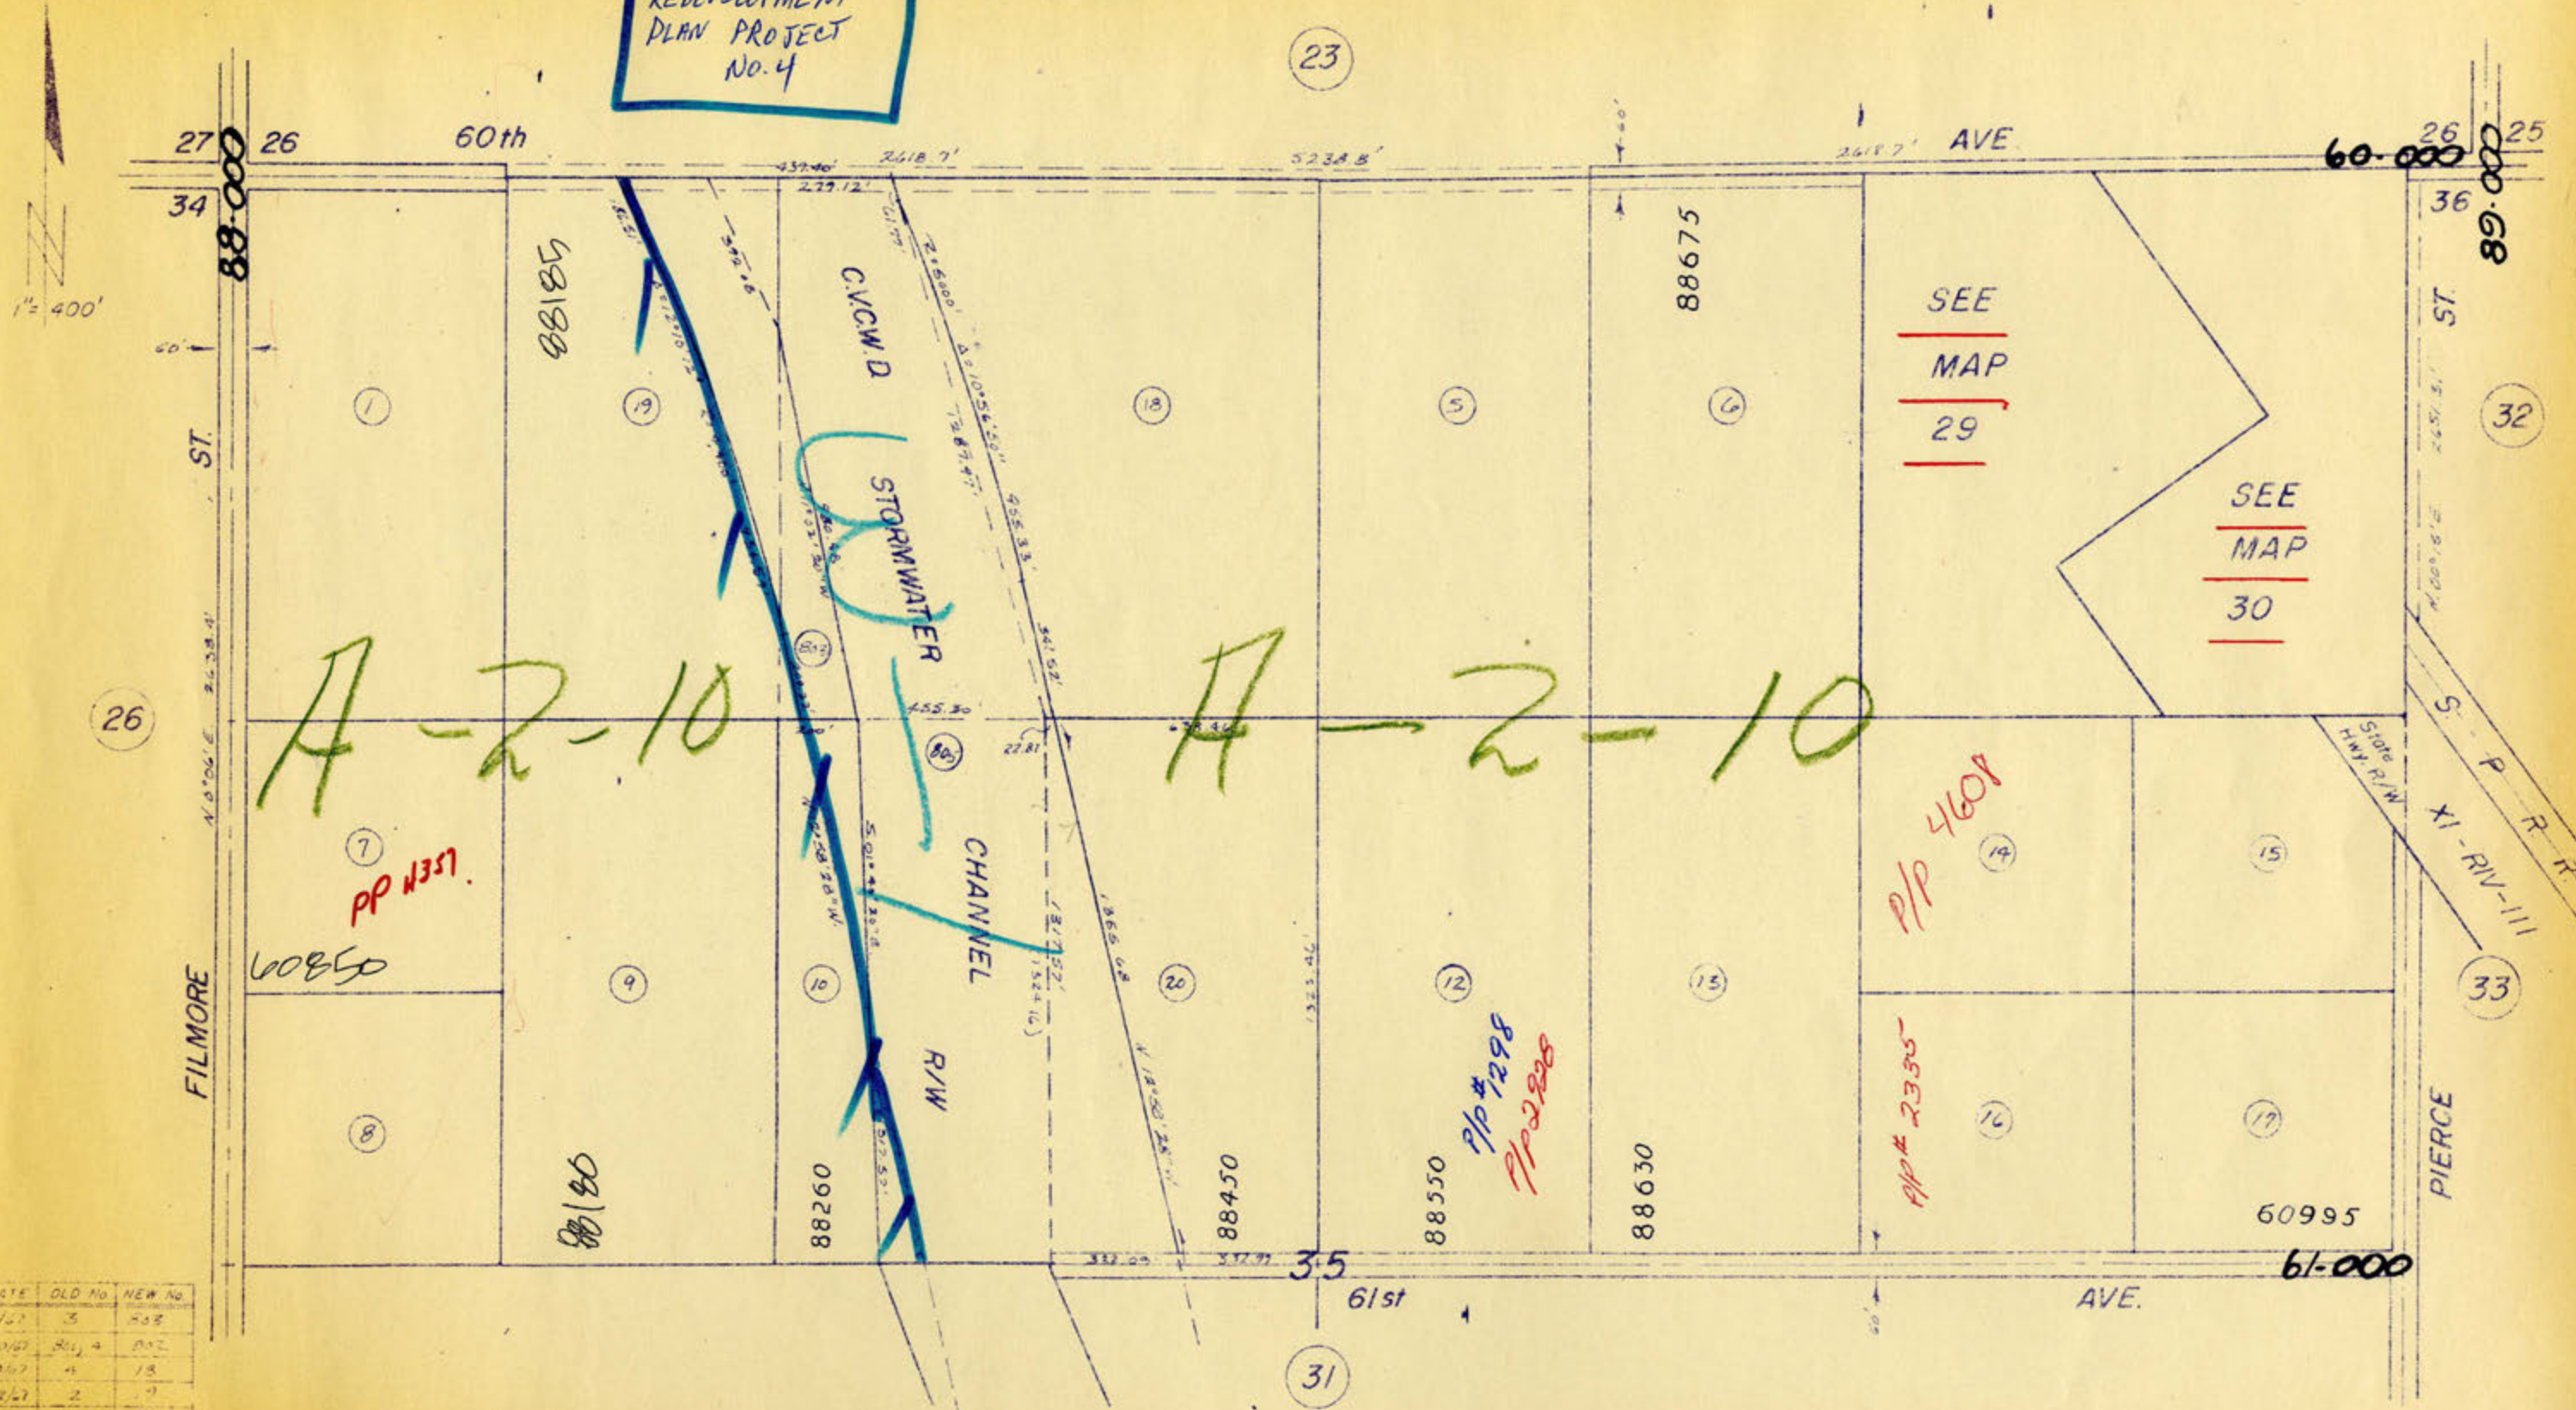

DATE	OLD NO	NEW NO
10/27	3	803
11/27	801, 4	802
10/27	4	13
12/27	2	17
12/27	802	804
3/28	4	805
5/28	11	20

DATA: G.L.C. Plat - 8H; RS 4/53, 5/26, C.V.C.W.D. R/W Maps - 21 & 66, Co. Sur. File - 1237, State Hwy. XI - RIV-III Maps, Co. Rd. Maps.

FEBRUARY 1967


ASSESSOR'S MAP BK. 757 PG. 28
RIVERSIDE COUNTY, CALIF.



DATA: RS4/53,5/26 STATE HWY XI-RIV-III R/W MAPS; S.B.E. 872-33-7A, Por. Pct. 5; Riv. Co. Civil File No 4288-Dec 1913;
U.S. Dept. of Interior-Topo. C-2N-188; G.L.C. Plat.

FEBRUARY 1967

ASSESSOR'S MAP BK.757 PG.29
RIVERSIDE COUNTY, CALIF.

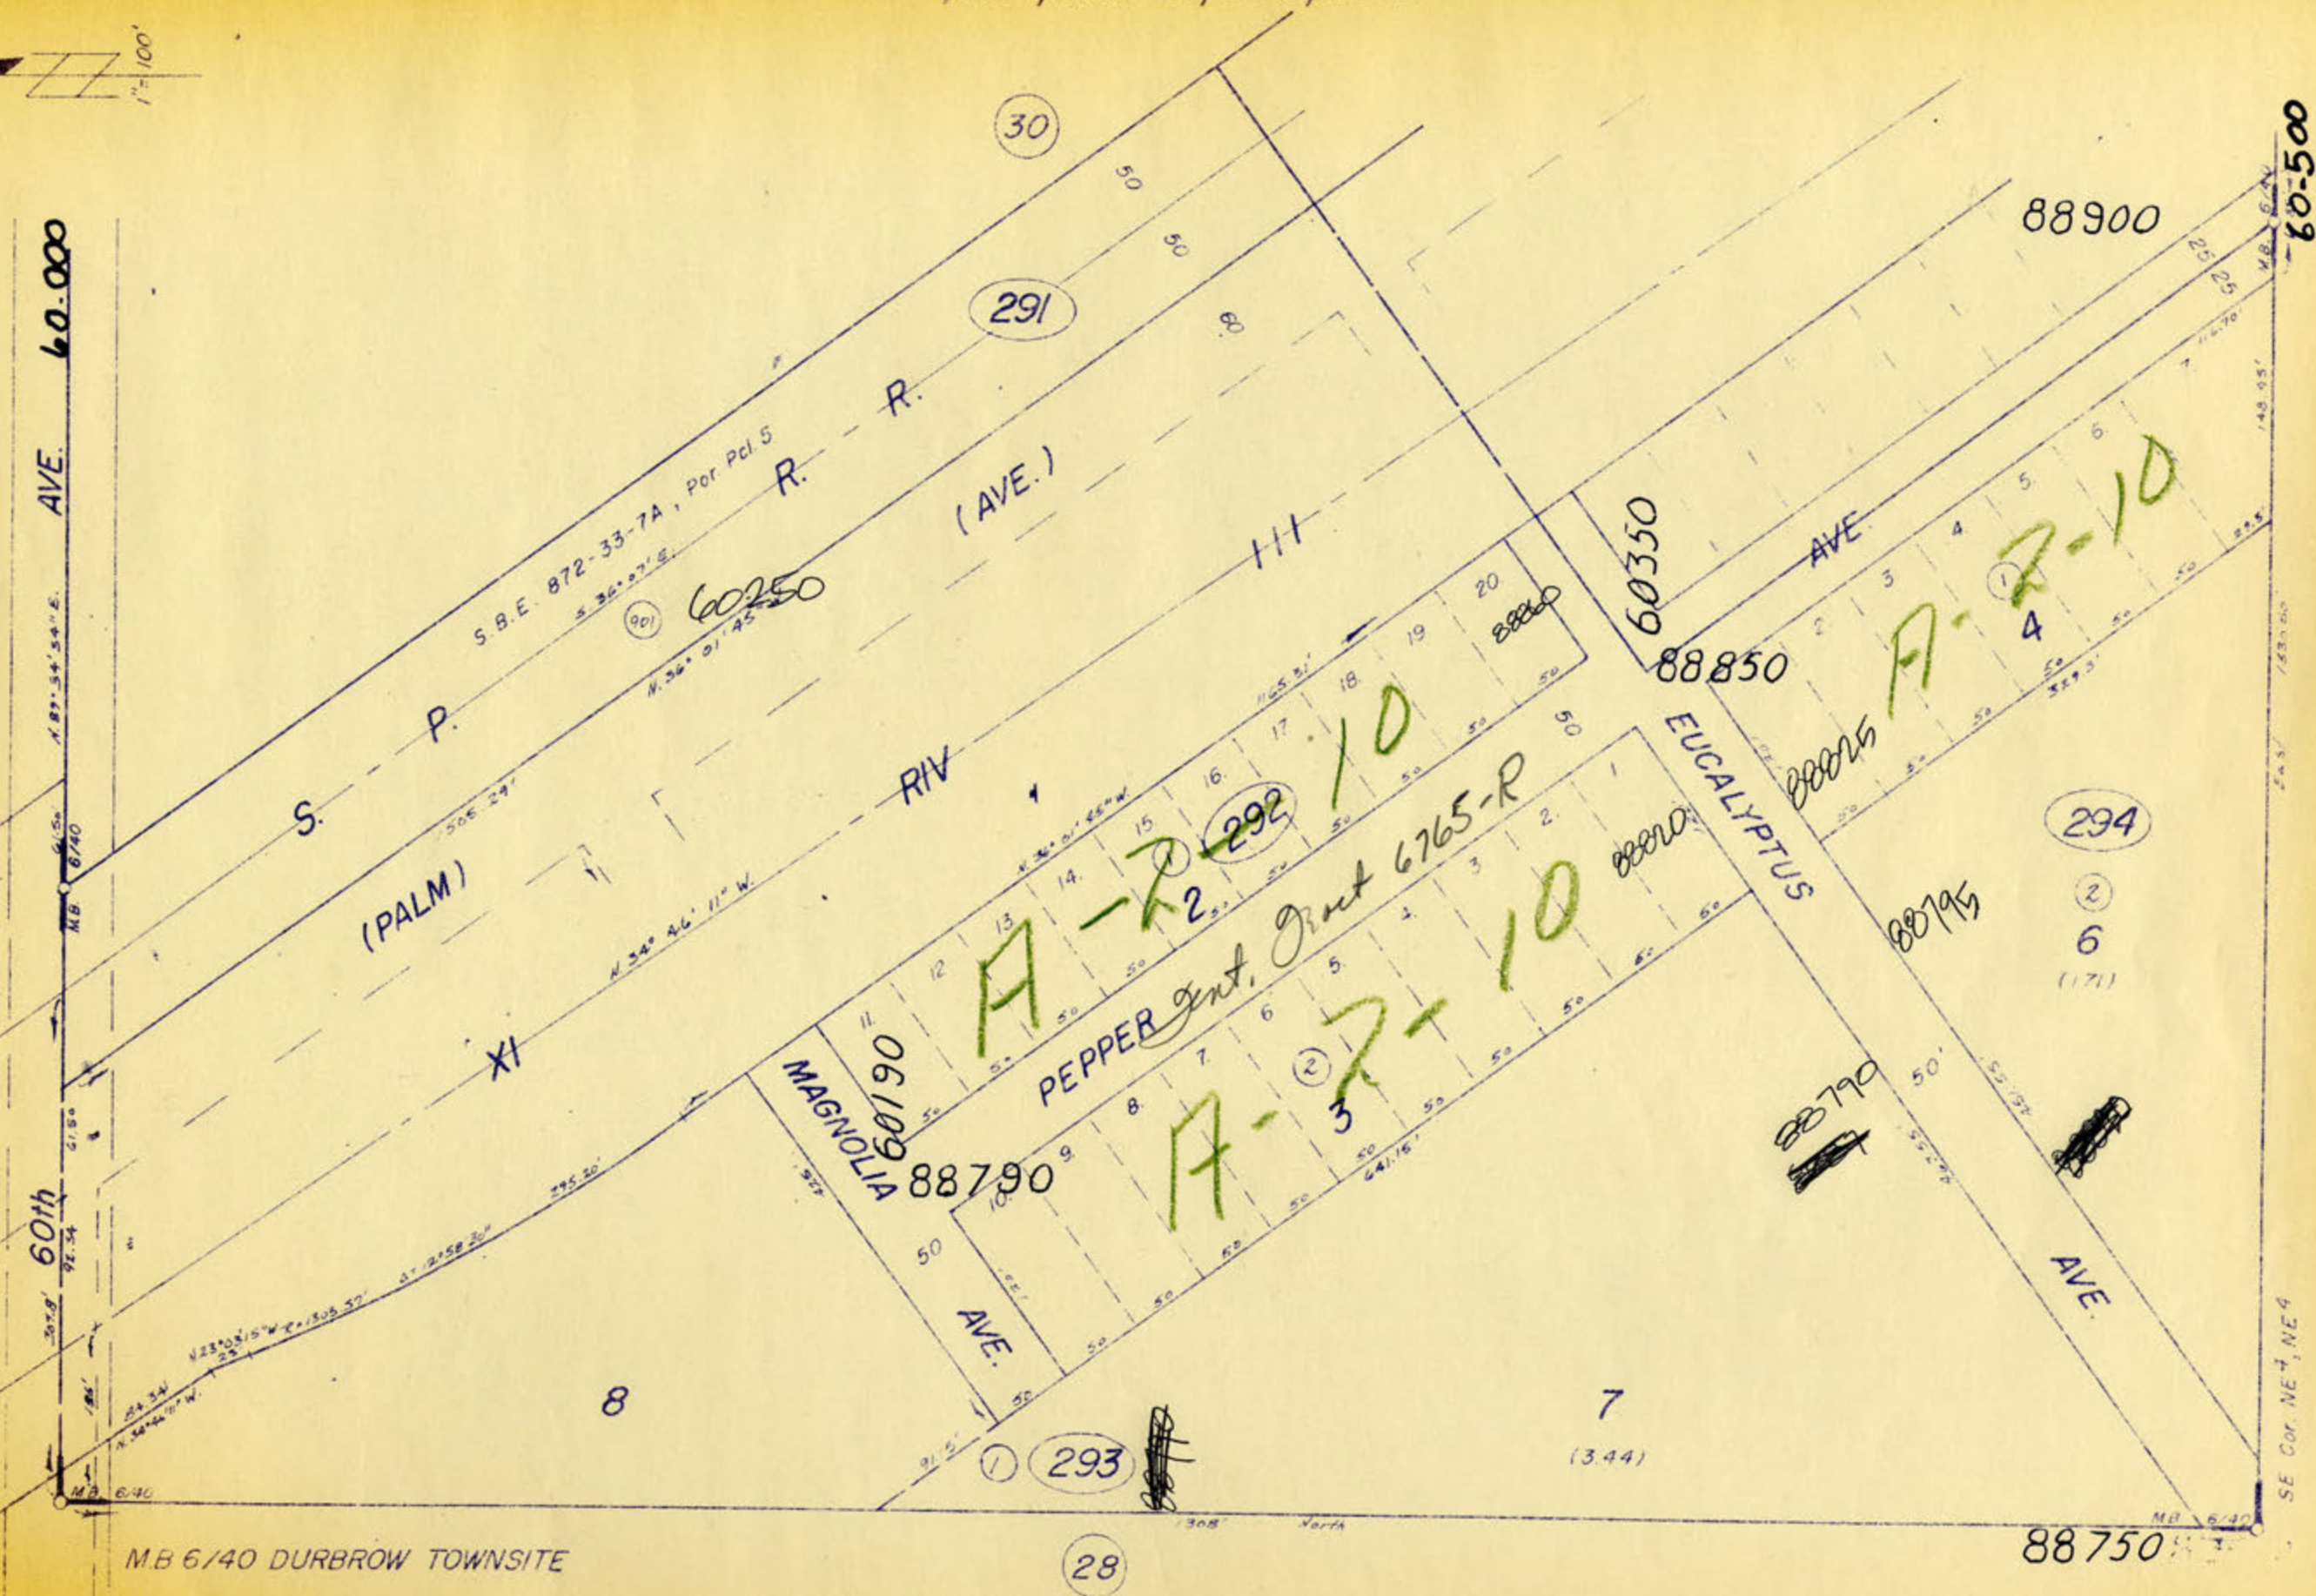

[illegible]

ALL IN
REDEVELOPMENT
PLAN PROJECT
NO. 4

$$l'' = 400'$$

15

COACHELLA VALLEY

Agri. Preserve

No. 63

page # 299

27

A-2-10⁽¹⁾

pp 11331

PM 3/62

cond case
1416-84

34

2

62nd

262.8

 $H^2 = S^1/E$

BK.
749

769

779

AVE

2

36

PIECE

34

DATE	OLD No.	NEW No.
11/67	389	802

DATA GOV'T PLAT, R.S. 4/58, 5/26, U.S. Dept. of Interior - Topo, CV.CW.D. STORMWATER CHANNEL. NAPS-218'56

FEBRUARY 1967

ASSESSOR'S MAP BK. 757 PG 31
RIVERSIDE COUNTY, CALIF. 100



ASSESSOR'S MAP BK 757 PG. 32
RIVERSIDE COUNTY, CALIF. 1982

25-45

POR. W², SEC. 36, T. 6 S., R. 8 E.

[illegible]

FEBRUARY 1967

ASSESSOR'S MAP BK.757 PG.33
RIVERSIDE COUNTY, CALIF

172



FEBRUARY 1967

ASSESSOR'S MAP BK.757 PG.34
RIVERSIDE COUNTY, CALIF.